



Ground floor
M 1:100

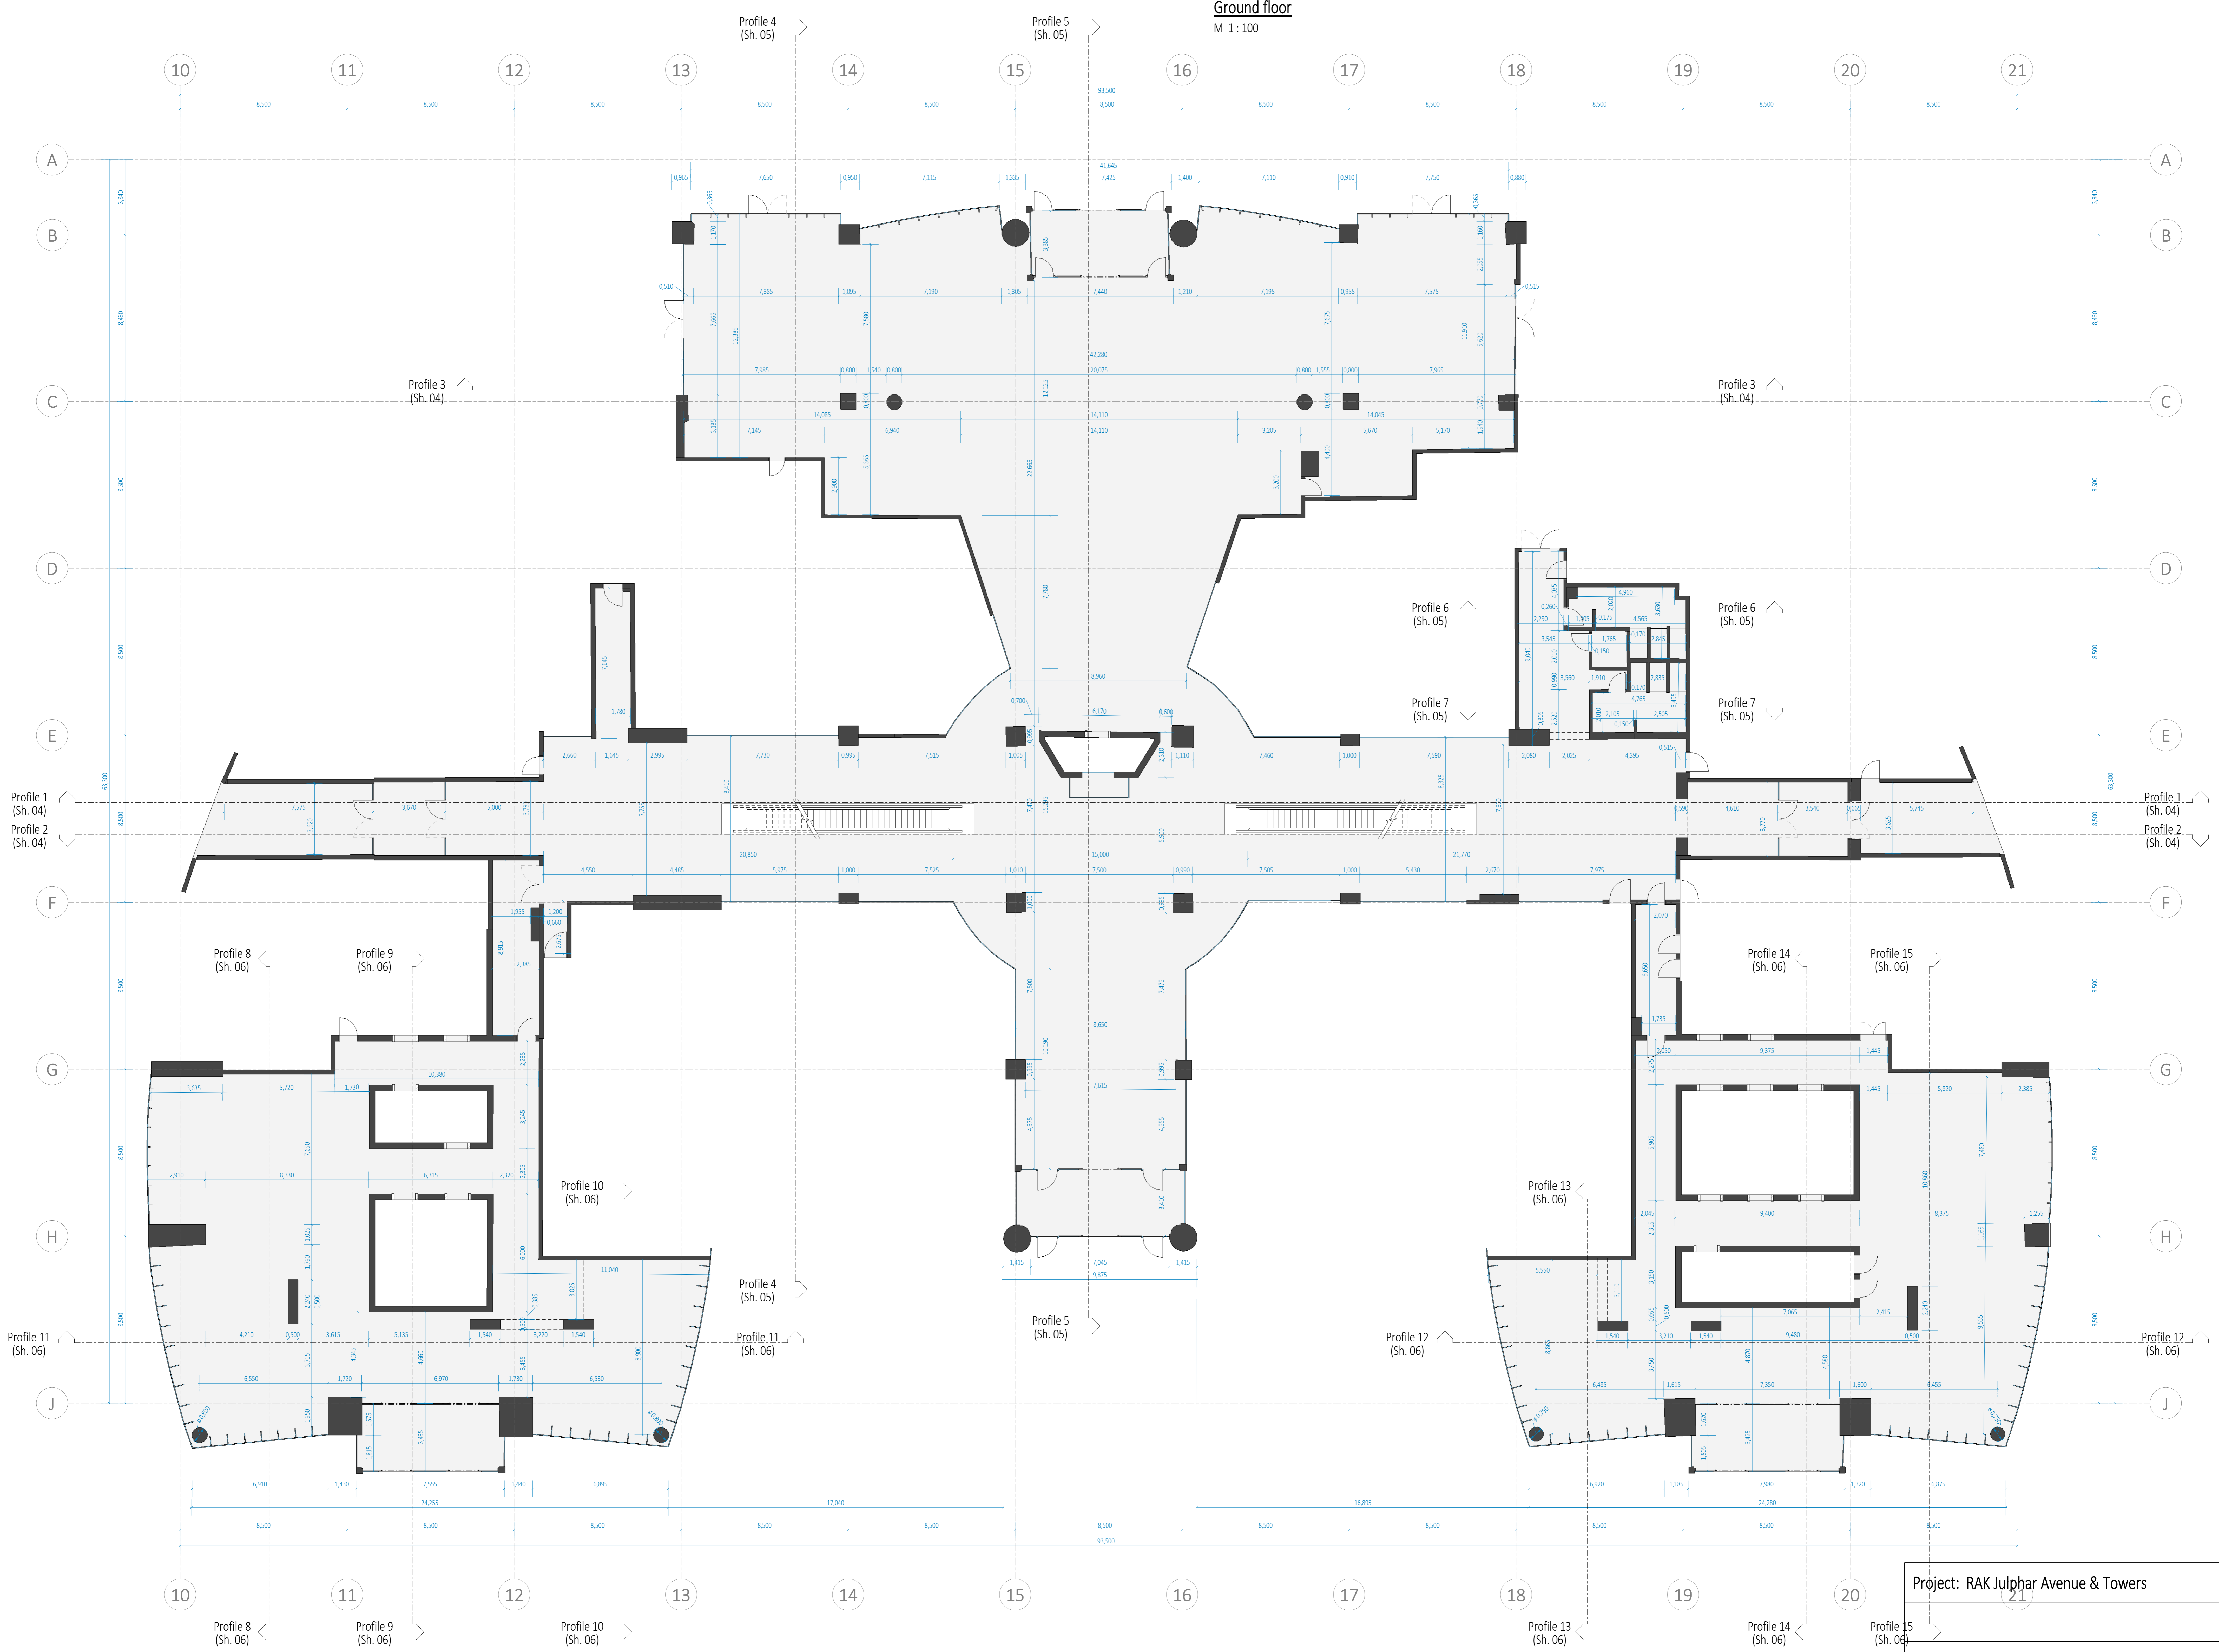

Project: RAK Julphar Avenue & Towers	
Drawing Status: as built	
Sheet No. 01	Scale 1:100
Date 06.02.2024	
00:31:024	

Ground floor


First floor
M 1 : 100

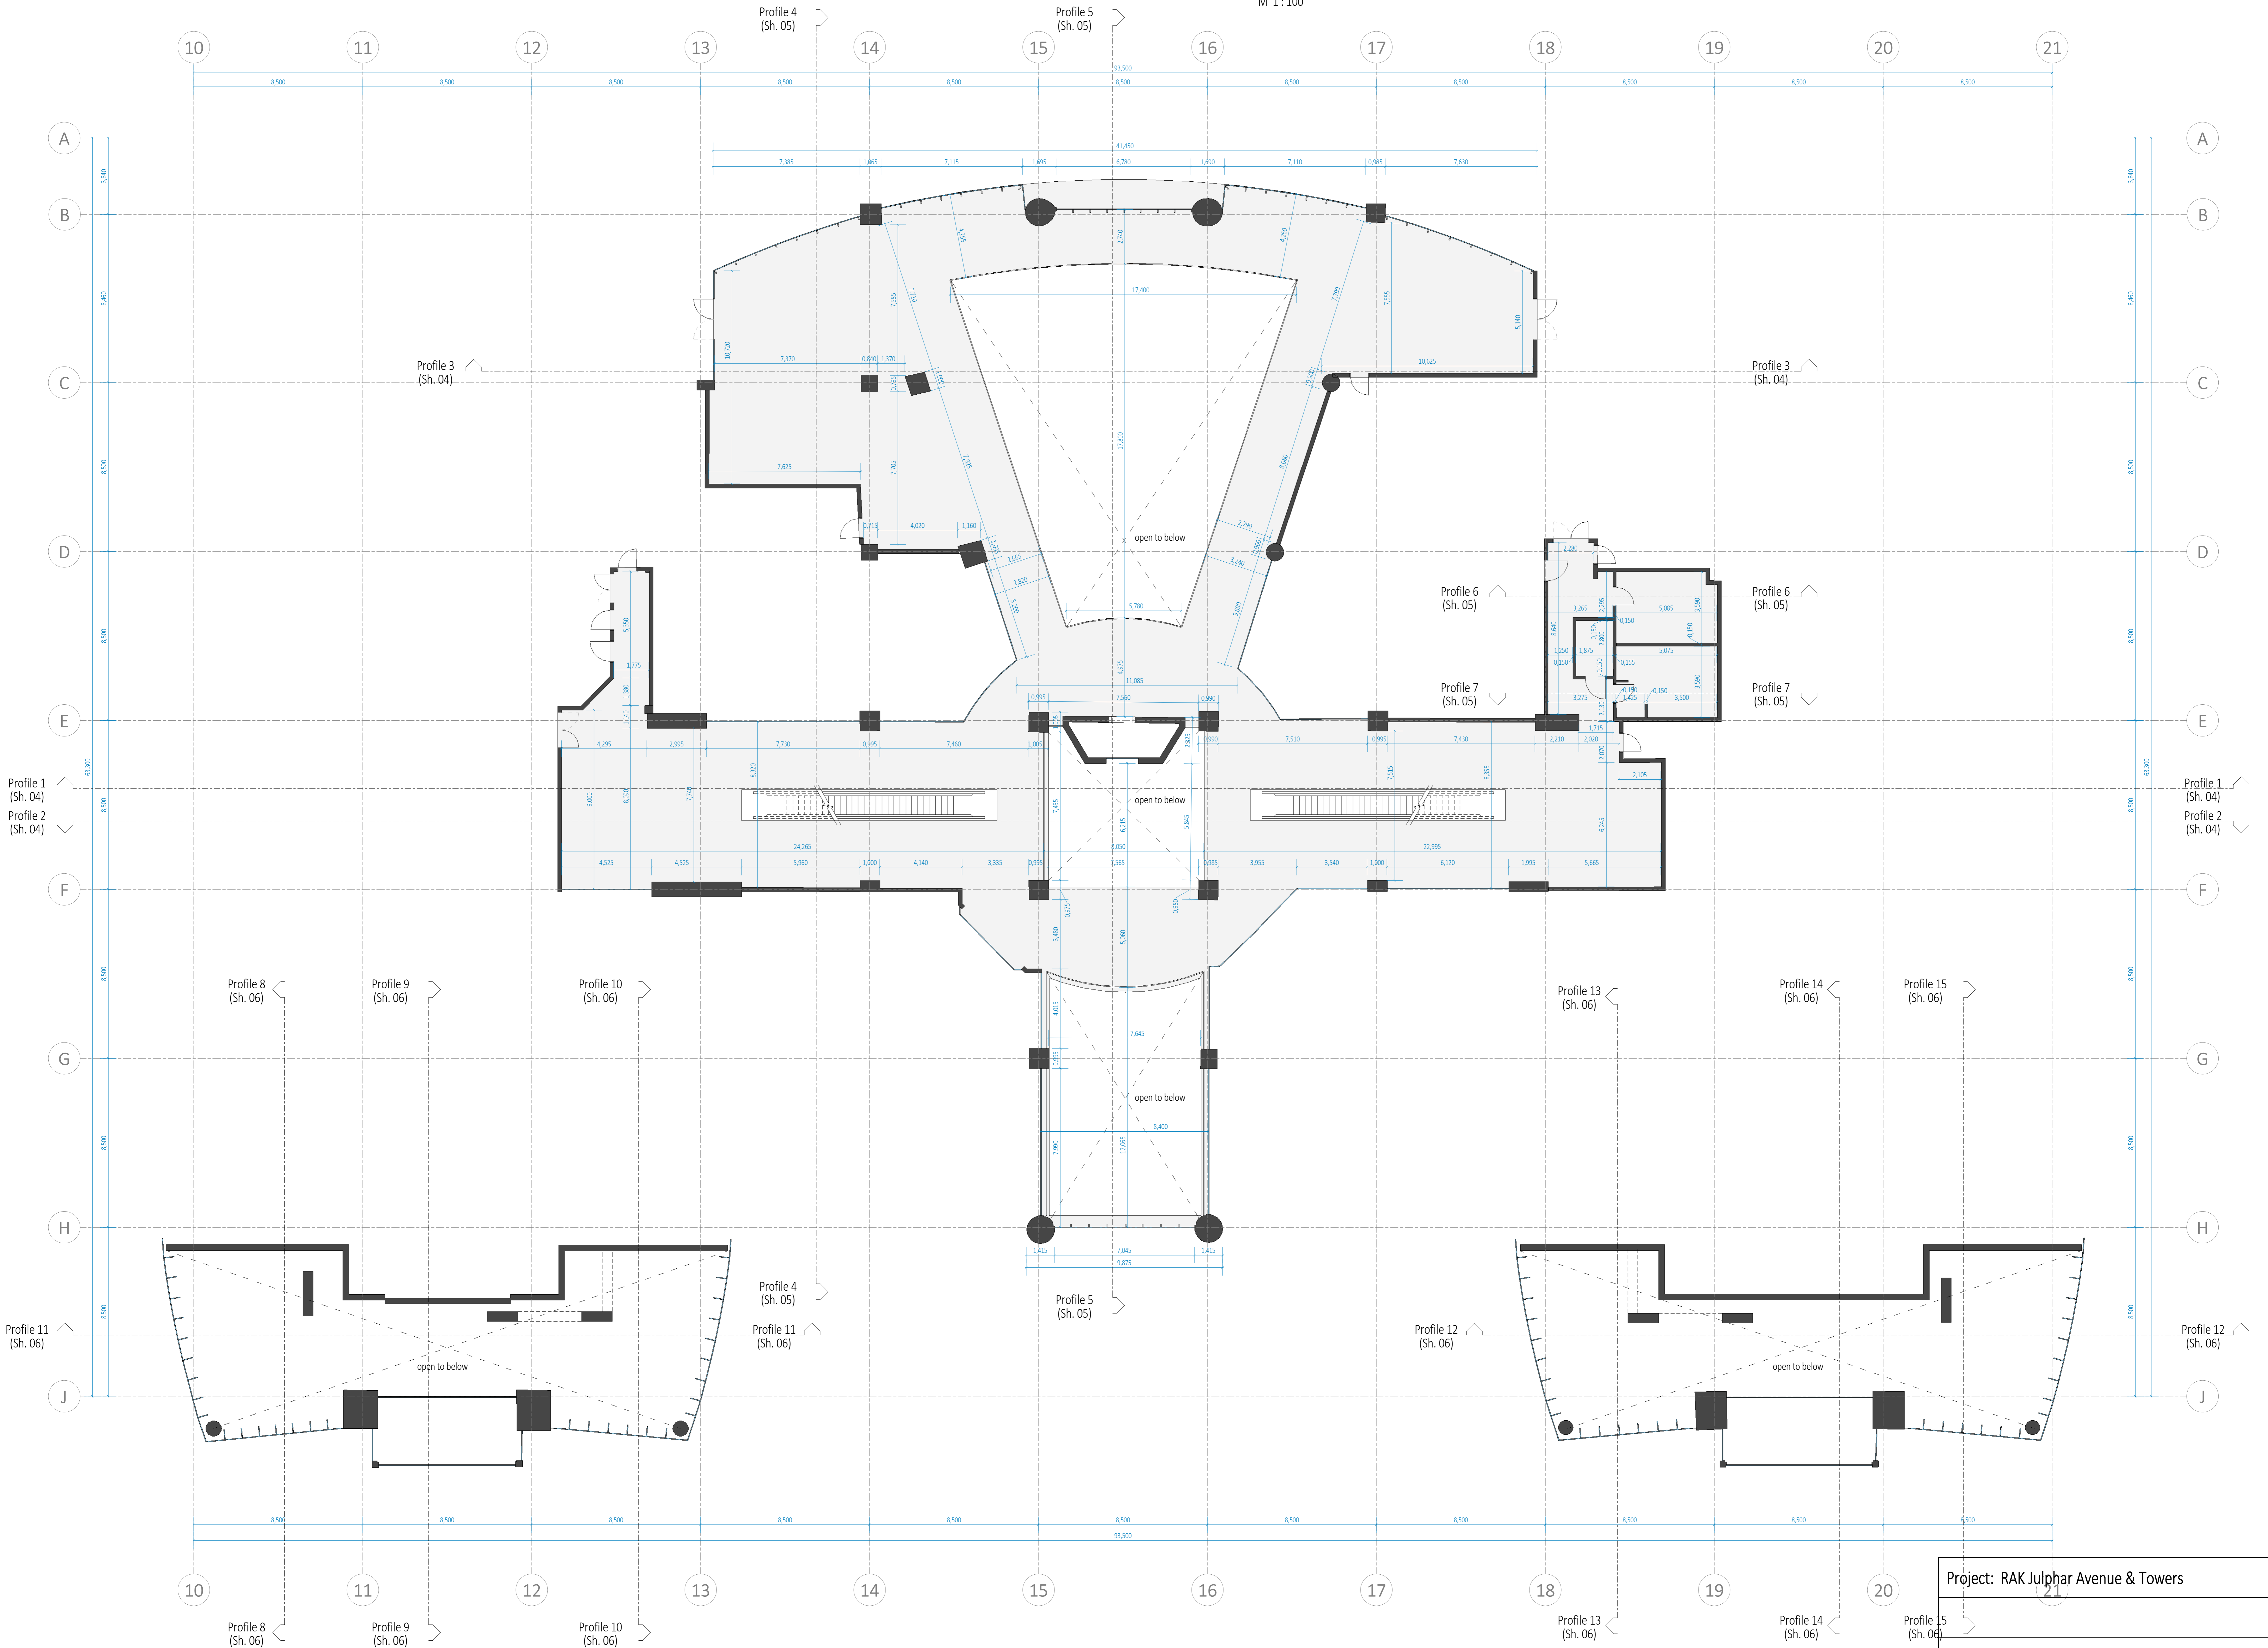

Project: RAK Julphar Avenue & Towers	
Drawing Status: as build	
Sheet No. 02	Scale 1:100
Date 06.02.2024	
00:31:11	

First floor

Second floor
M 1:100

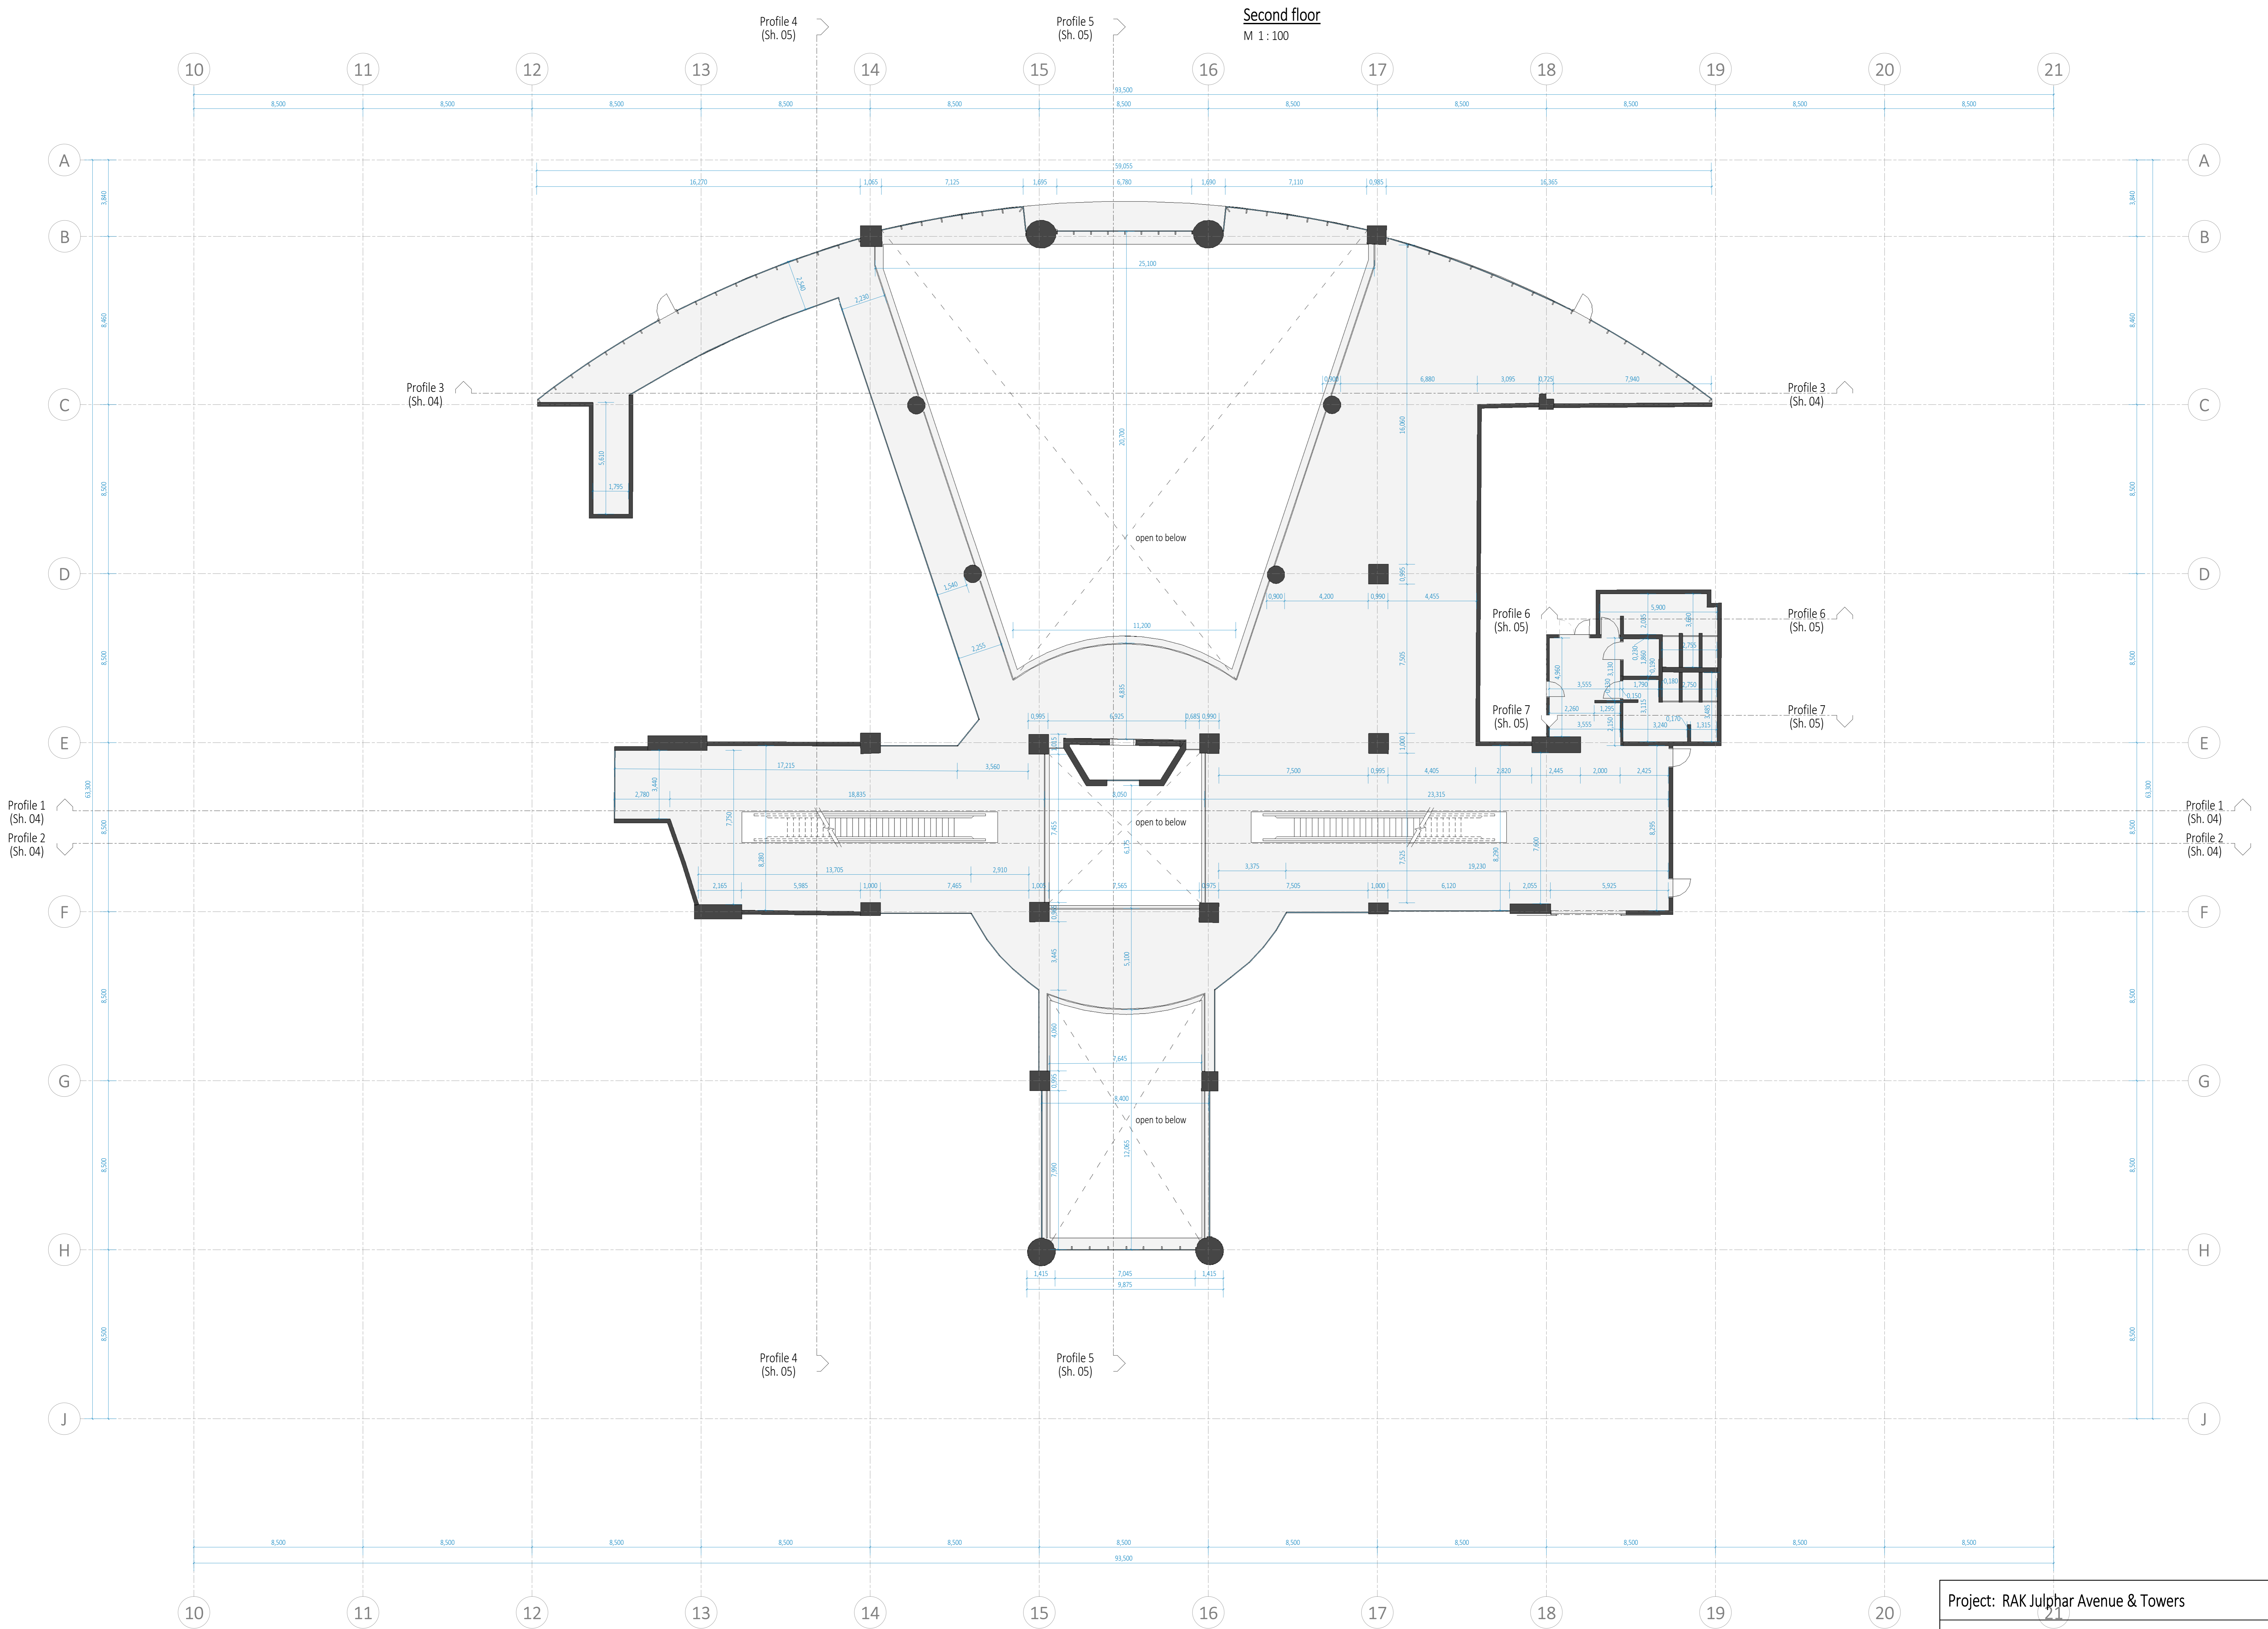

Project: RAK Julphar Avenue & Towers

Sheet No. 03


Scale: 1:100

Date: 06.02.2024


Drawing Status: as build

00:31:14


Profile 1
M 1 : 100

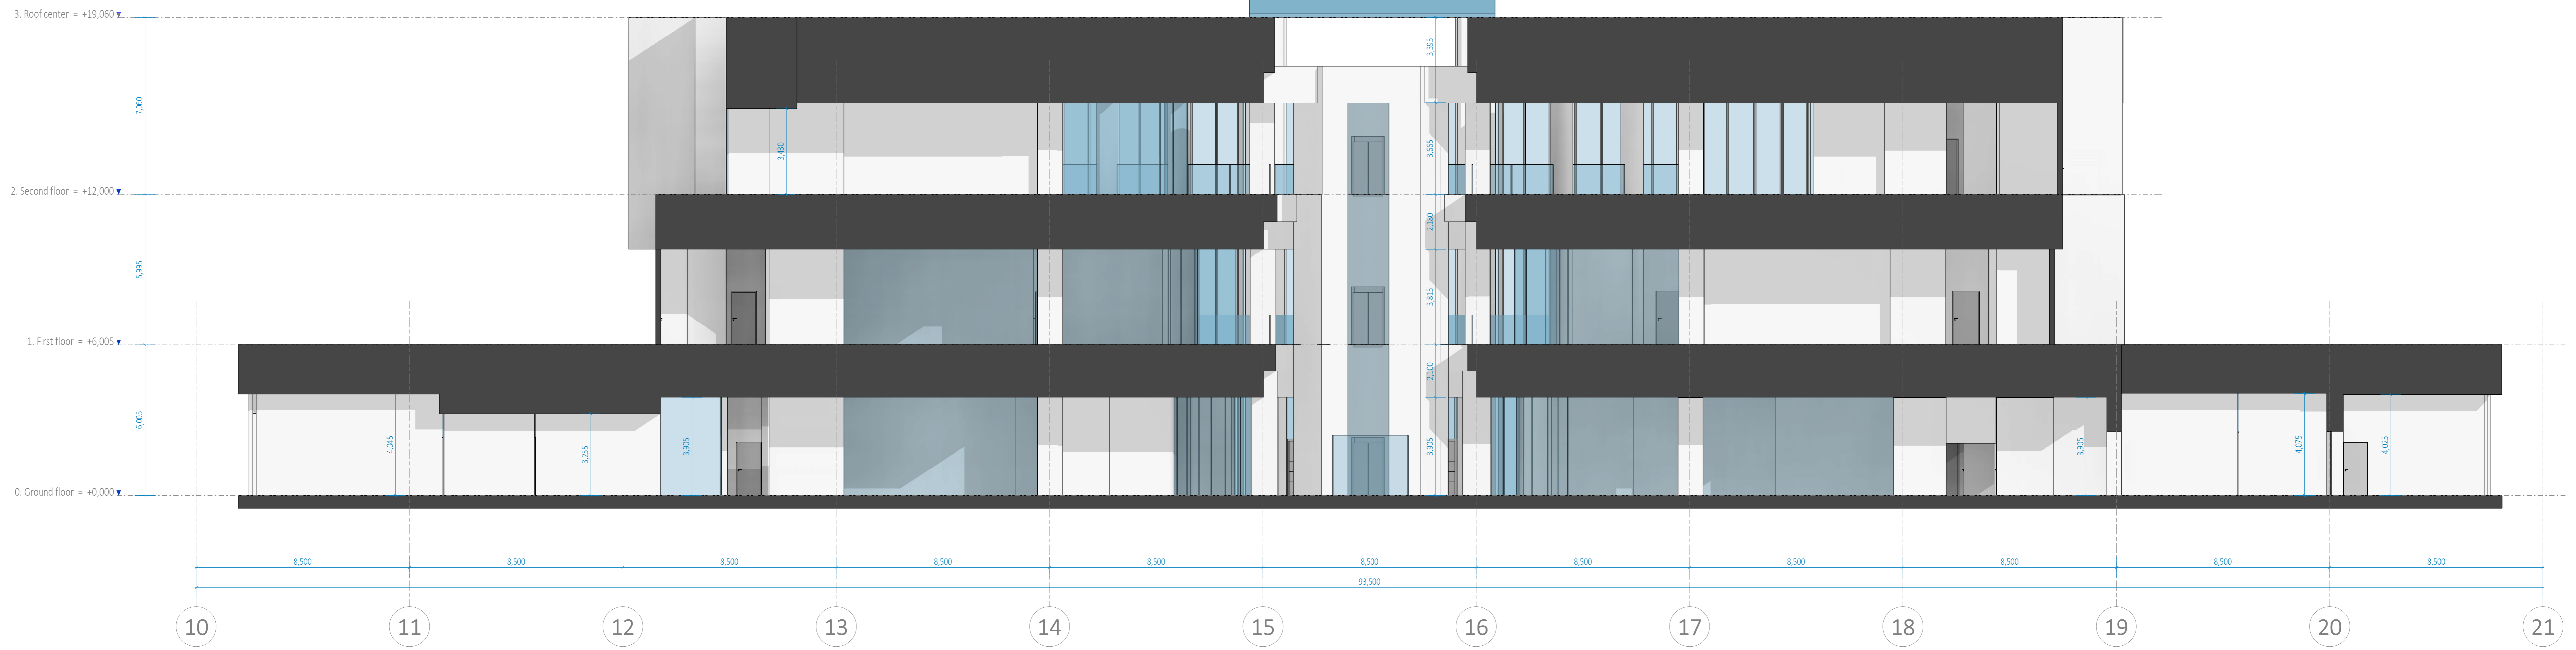

Profile 2
M 1 : 100

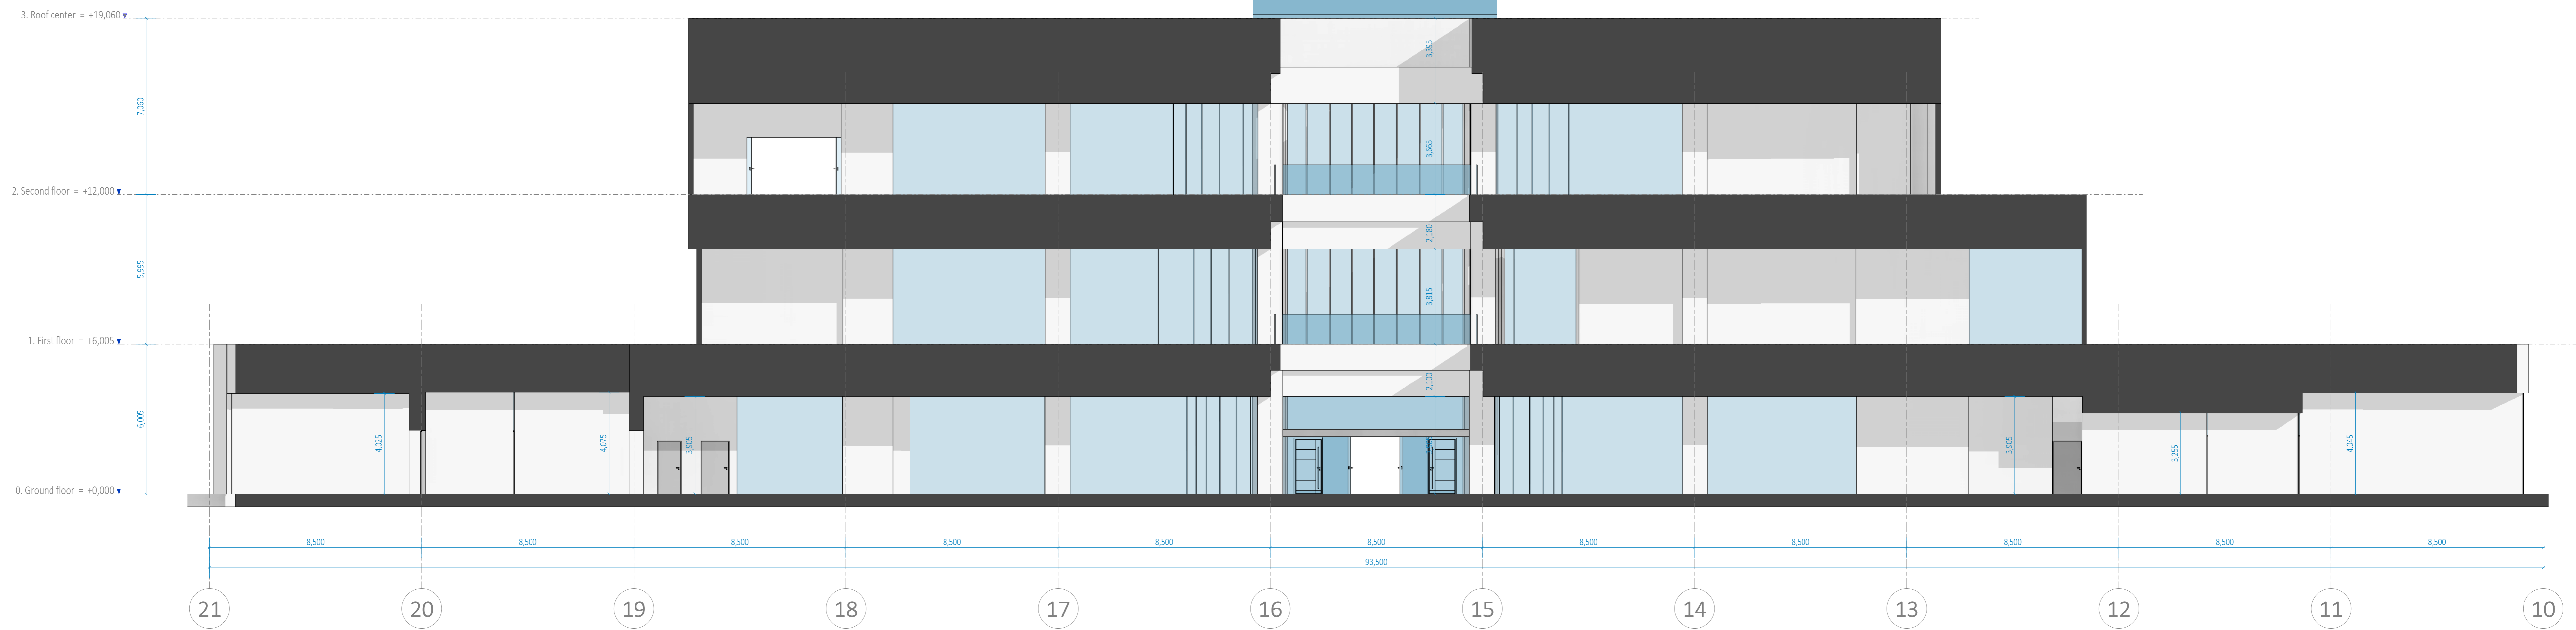

Profile 3
M 1 : 100

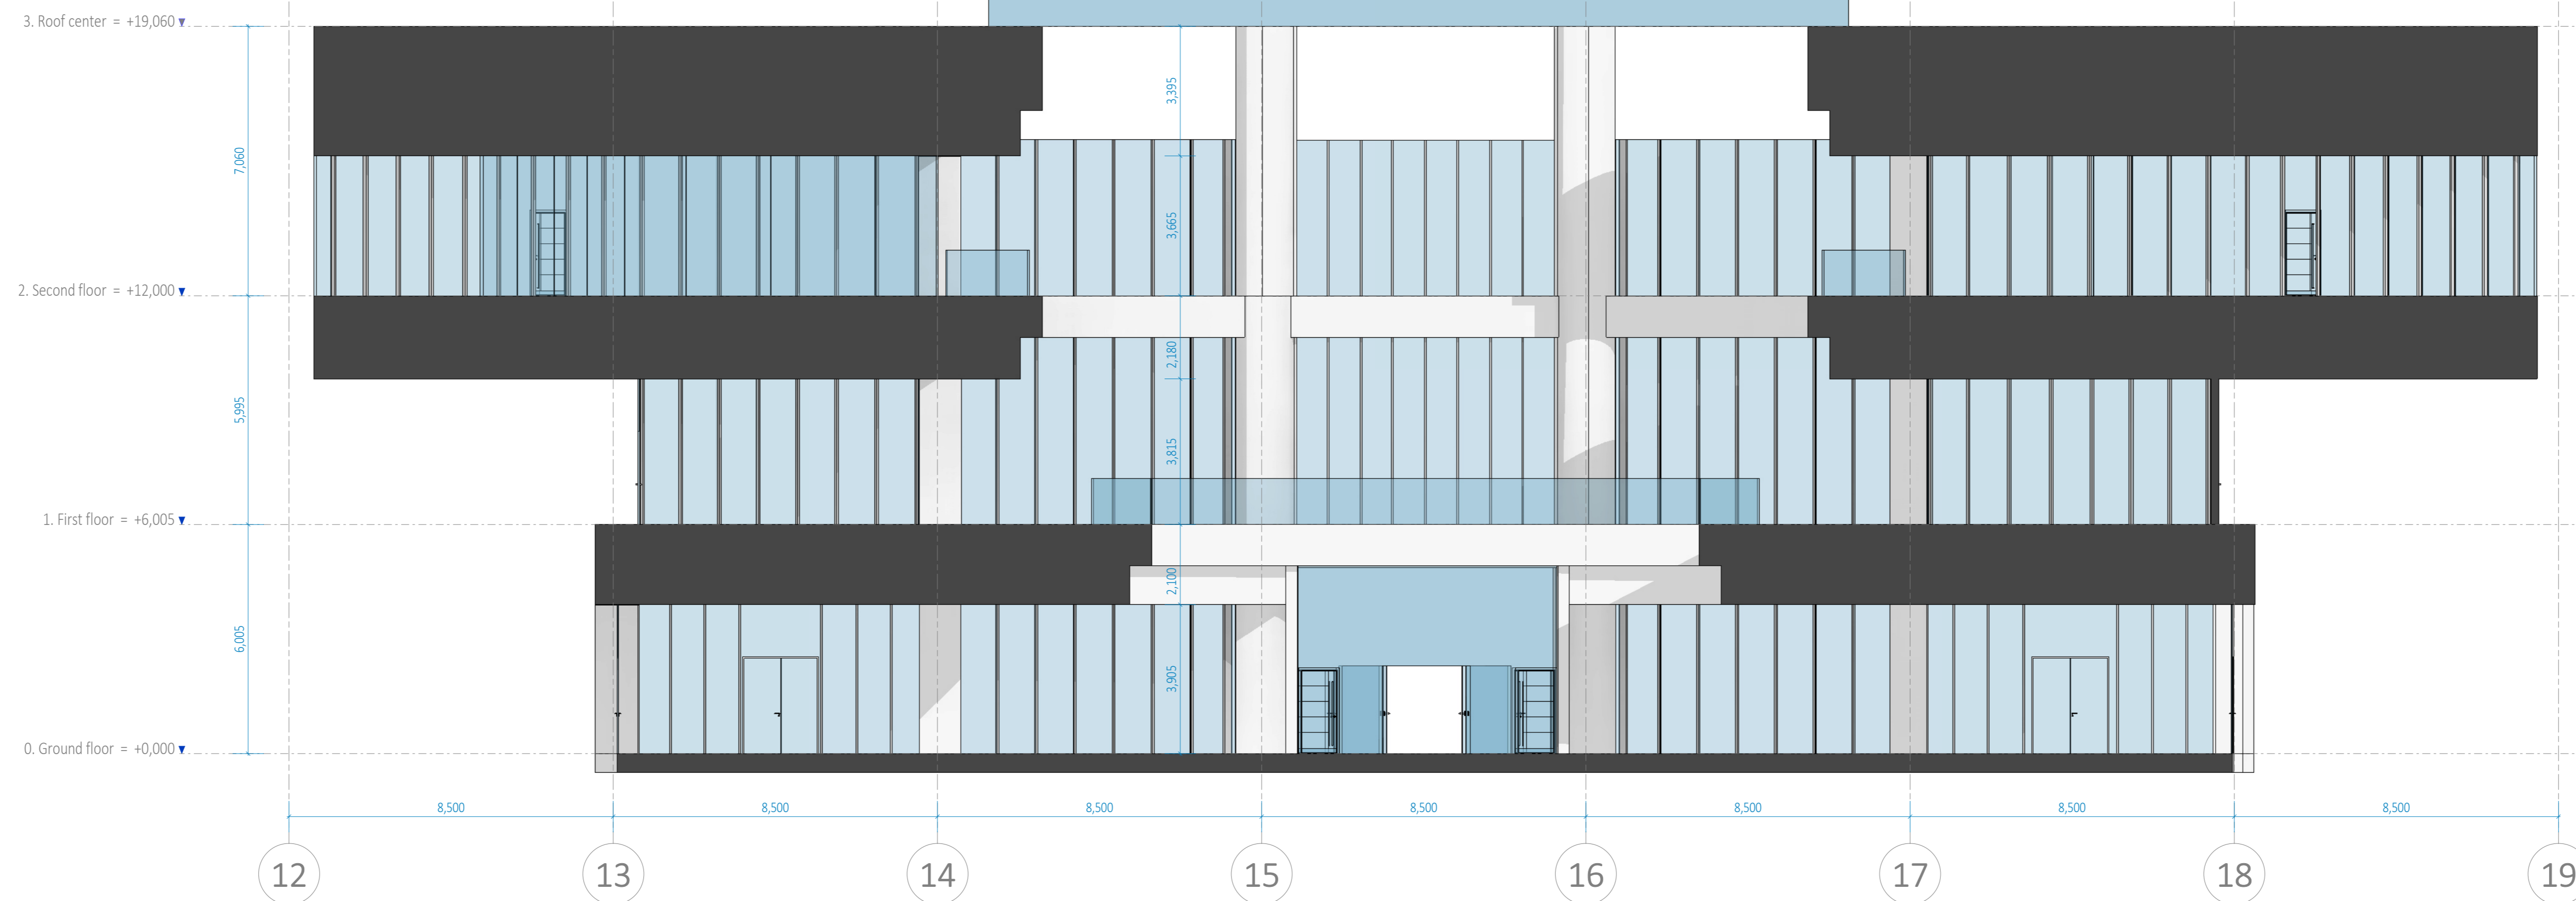


Project: RAK Julphar Avenue & Towers


Profile 1, Profile 2, Profile 3

Sheet No.	Scale
04	1 : 100
Date	06.02.2024
	00:31:18

Profile 4
M 1:100

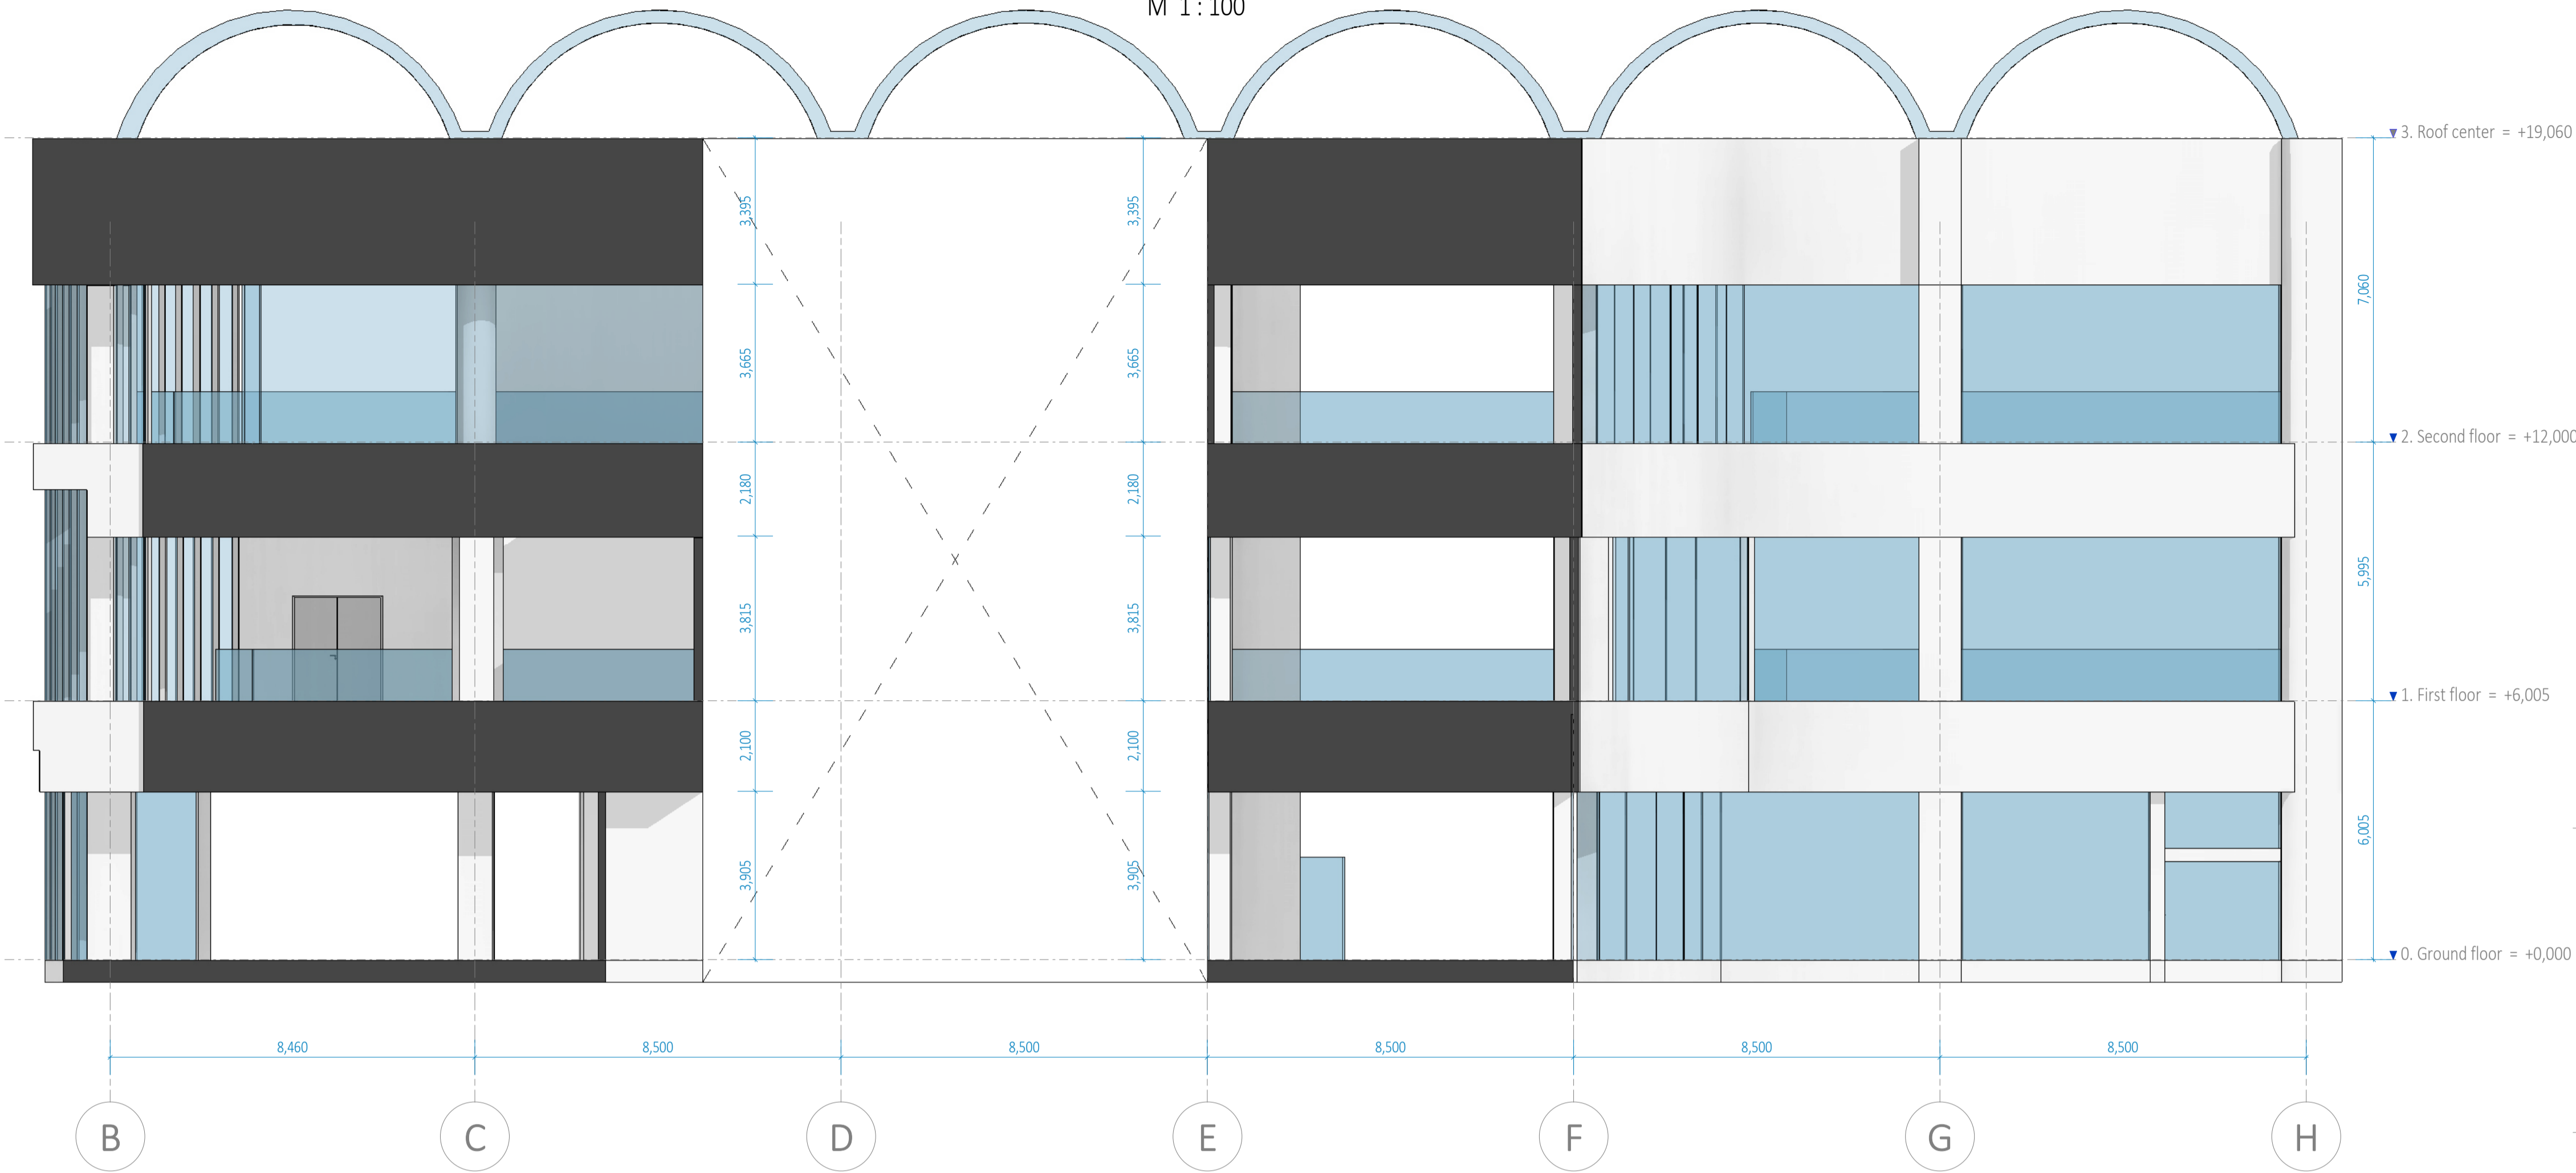


Profile 5
M 1:100

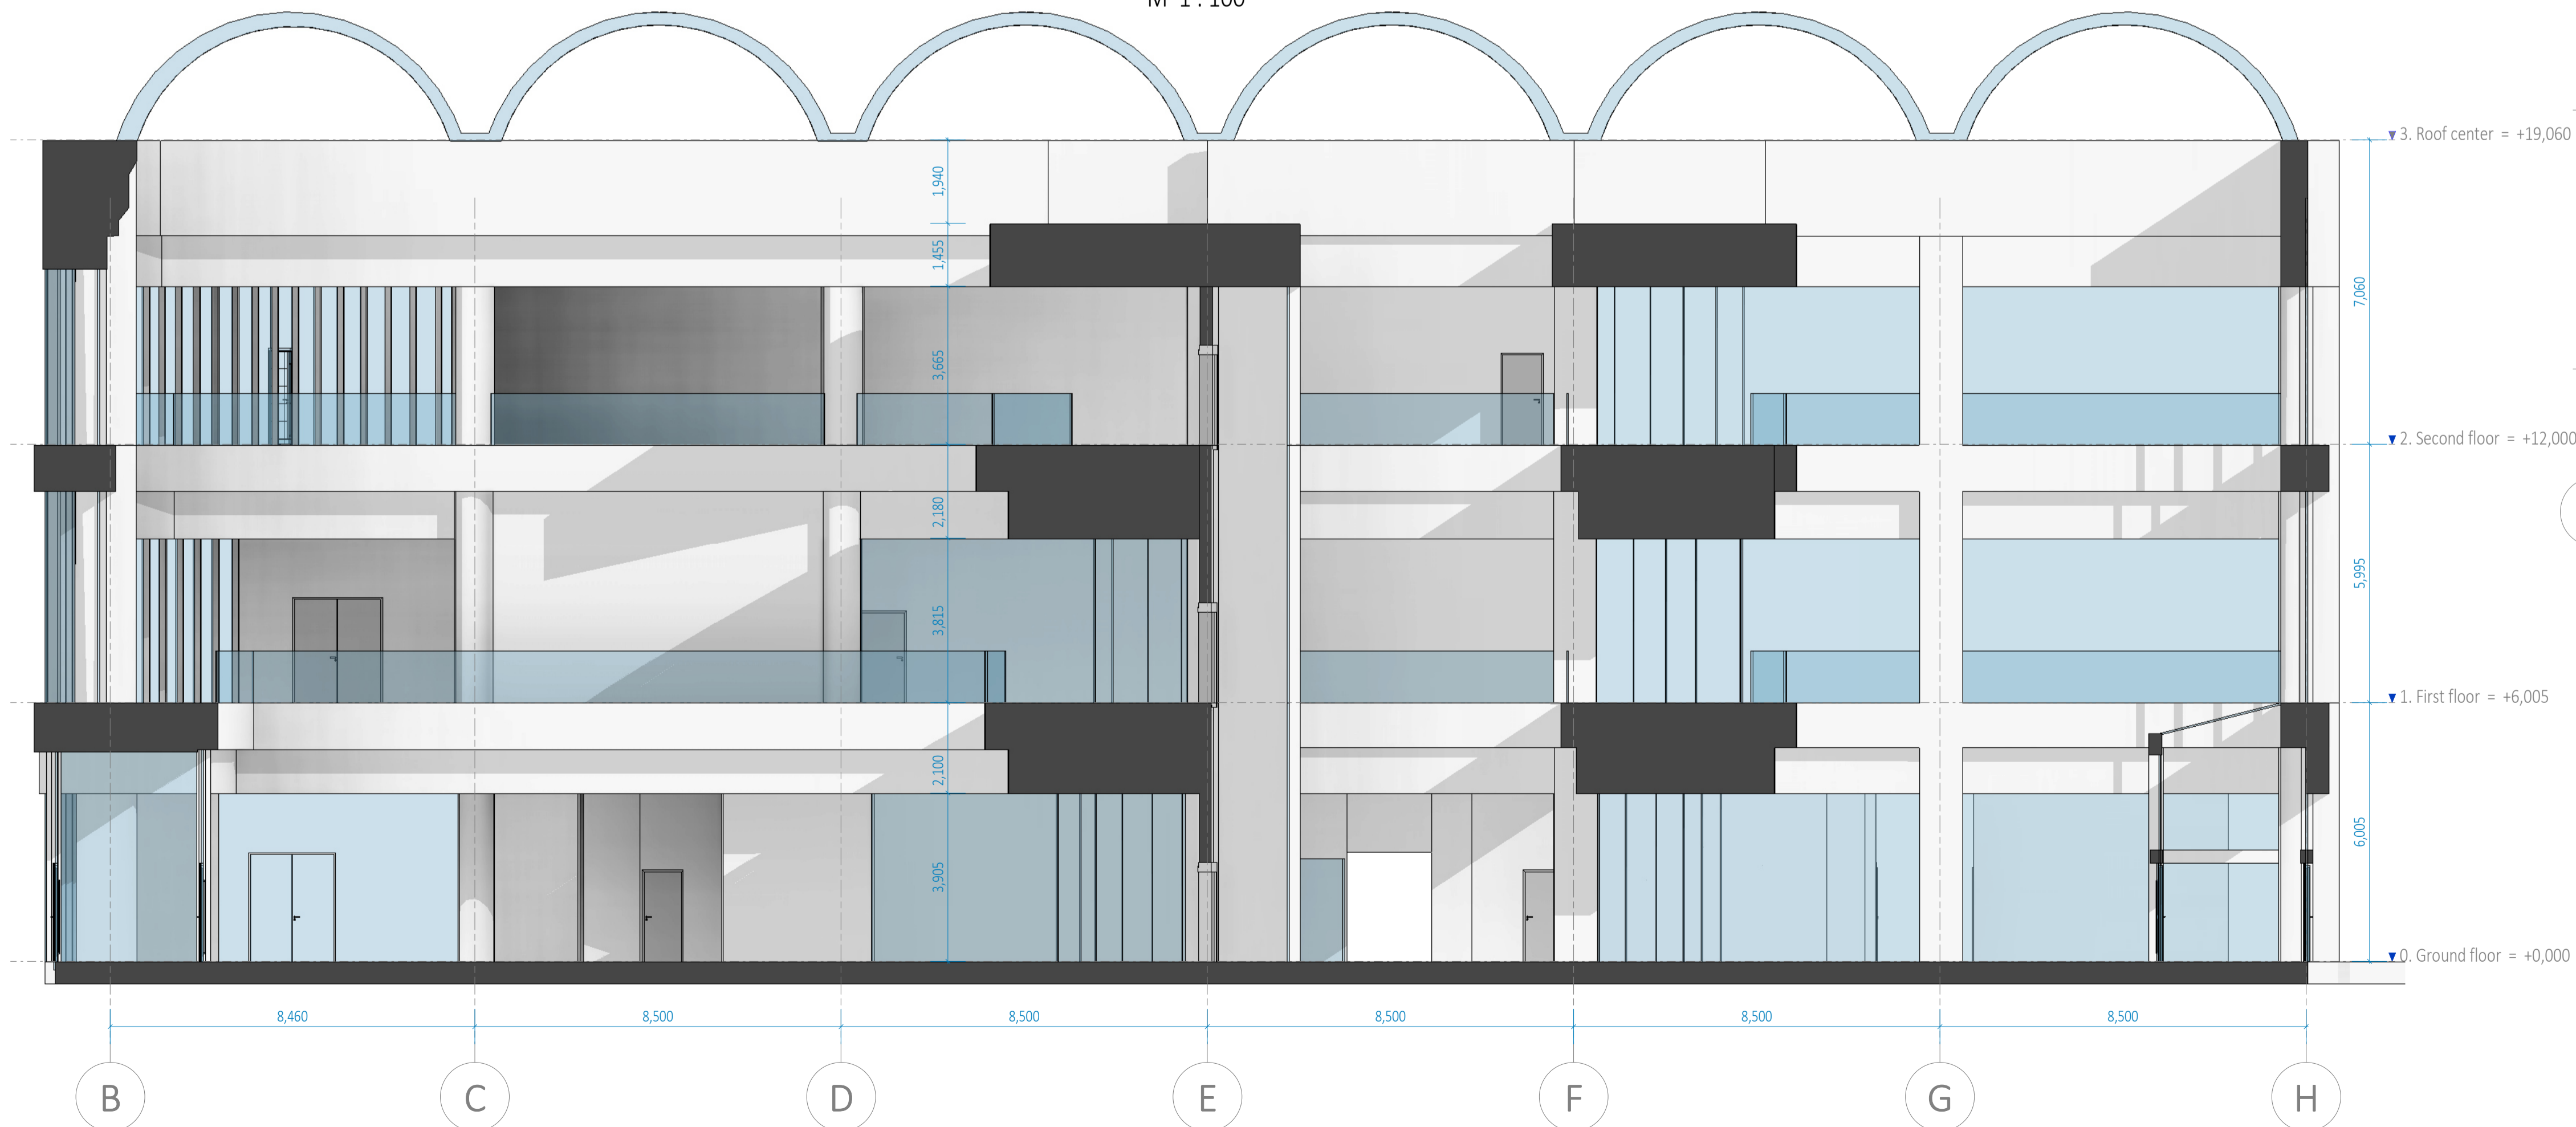

Profile 6
M 1:100



Profile 7
M 1:100

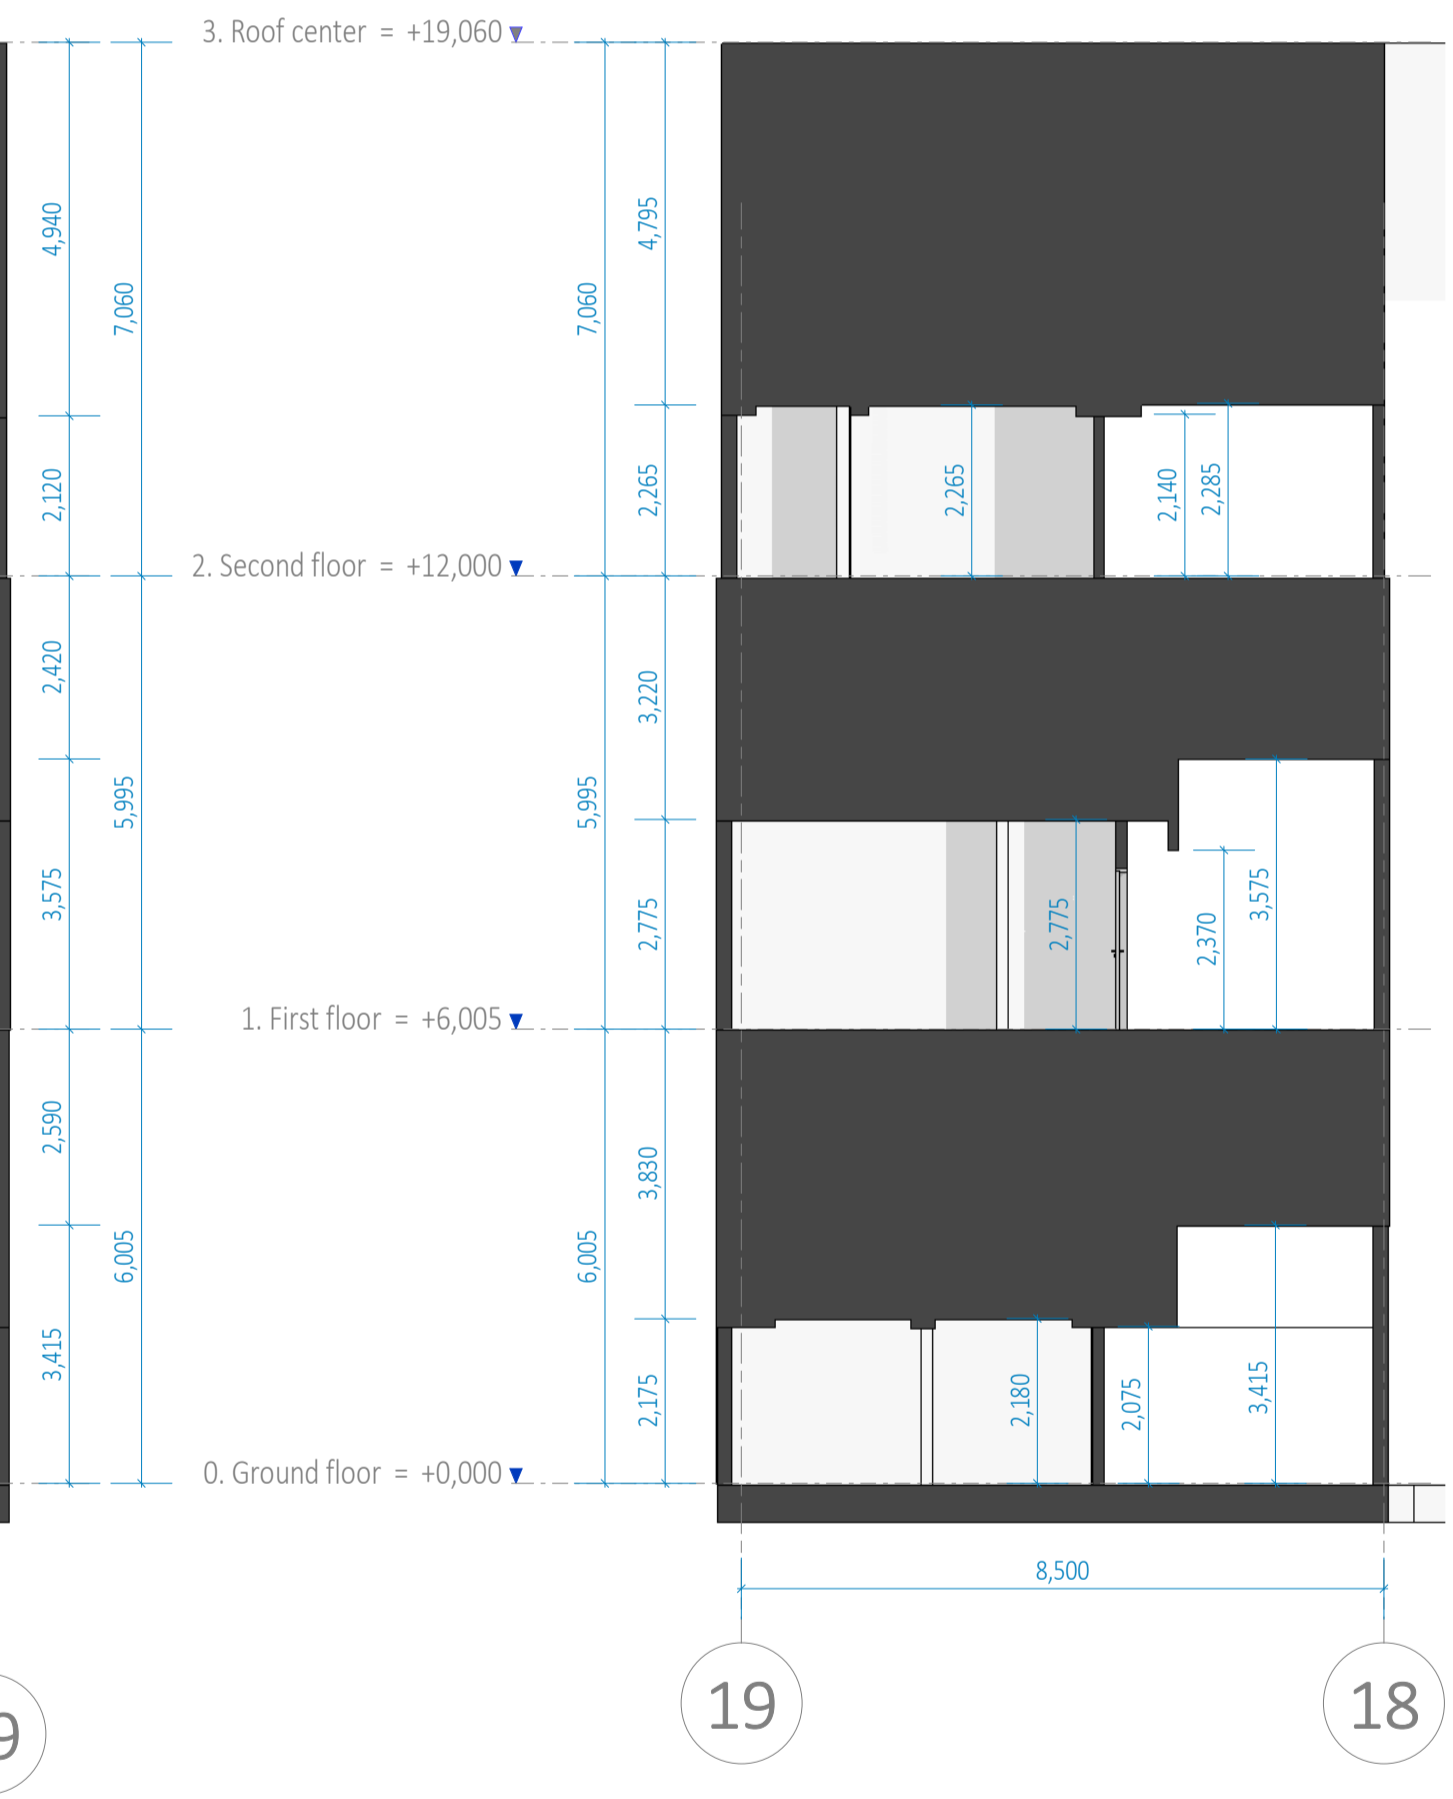

Project: RAK Julphar Avenue & Towers


Profiles 4 - 7

Sheet No.	Scale
05	1:100
Date	
06.02.2024	


00:31:22

0.04x0.04x0.04mm

Profile 8
M 1 : 100

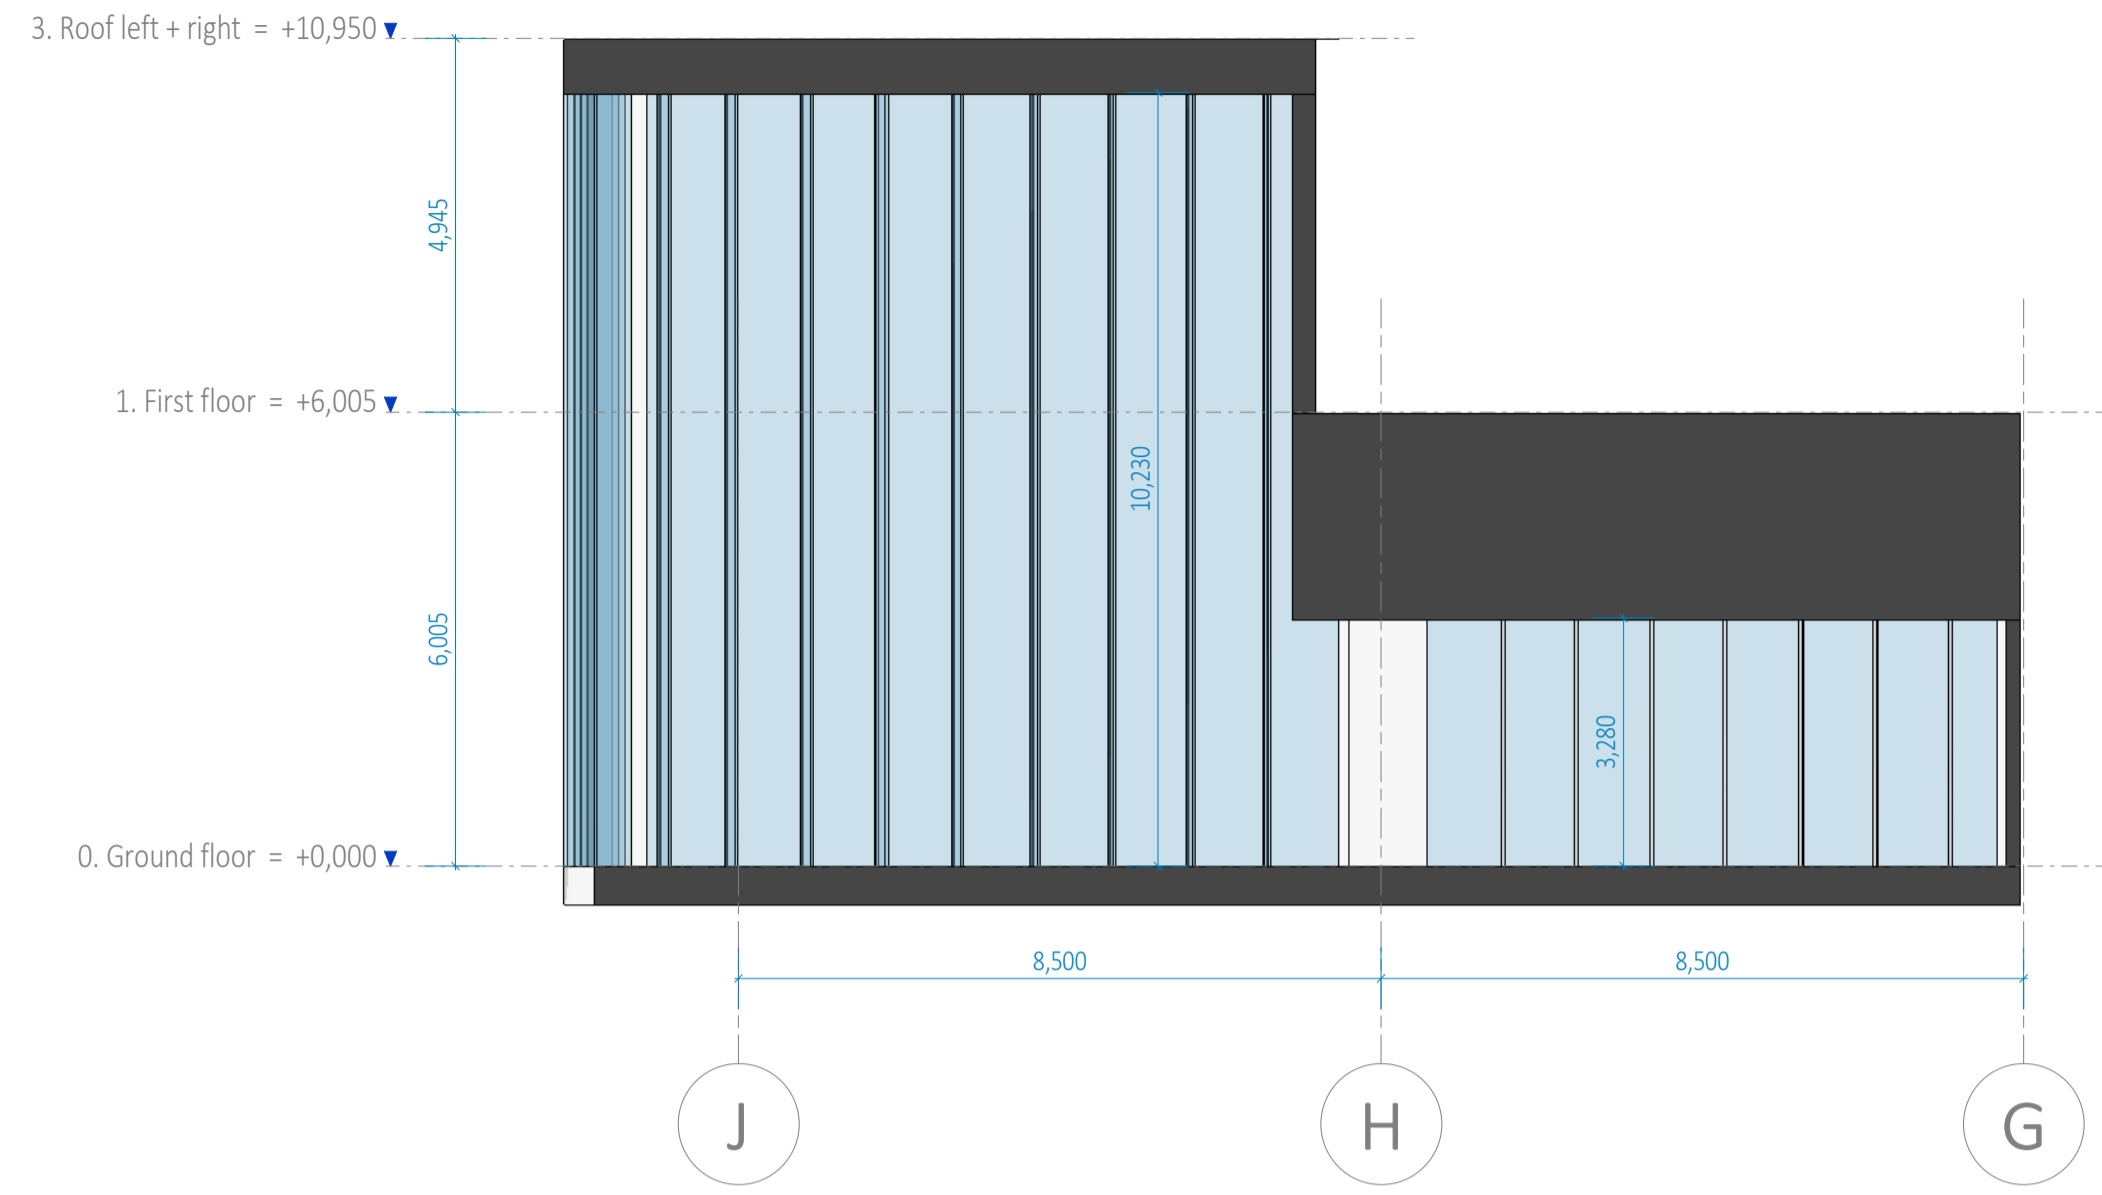


Profile 13
M 1 : 100

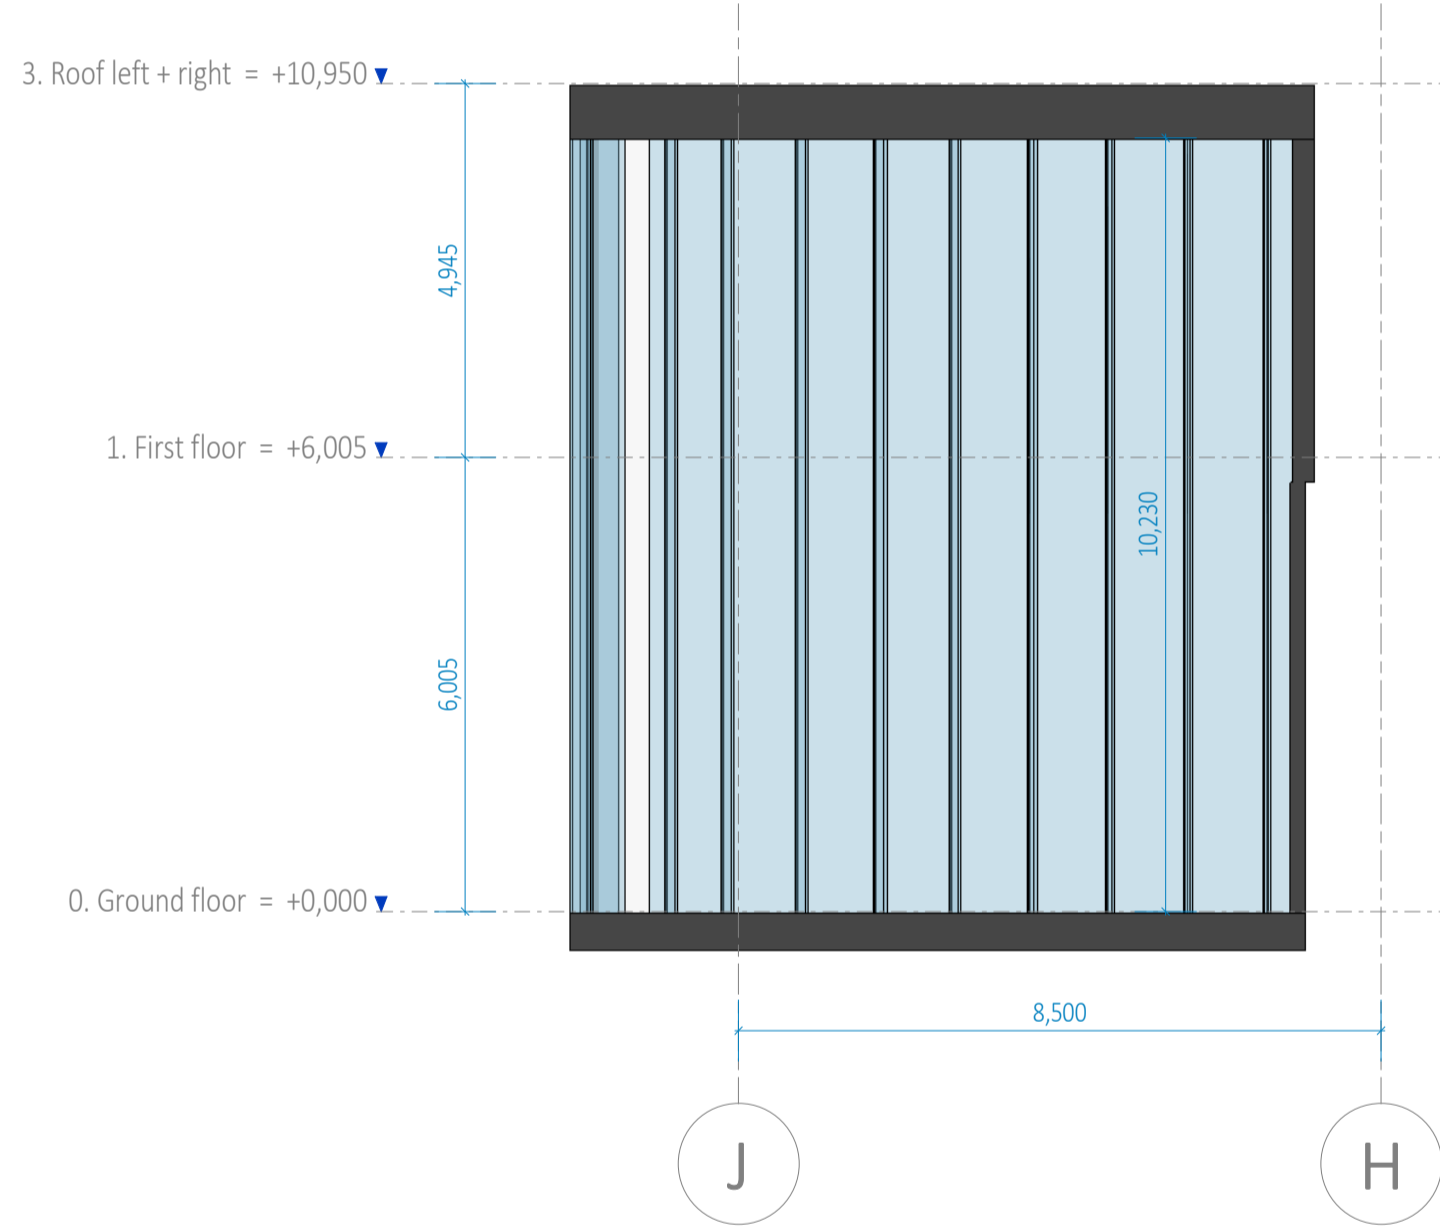


Profile 11
M 1 : 100



Profile 9
M 1 : 100

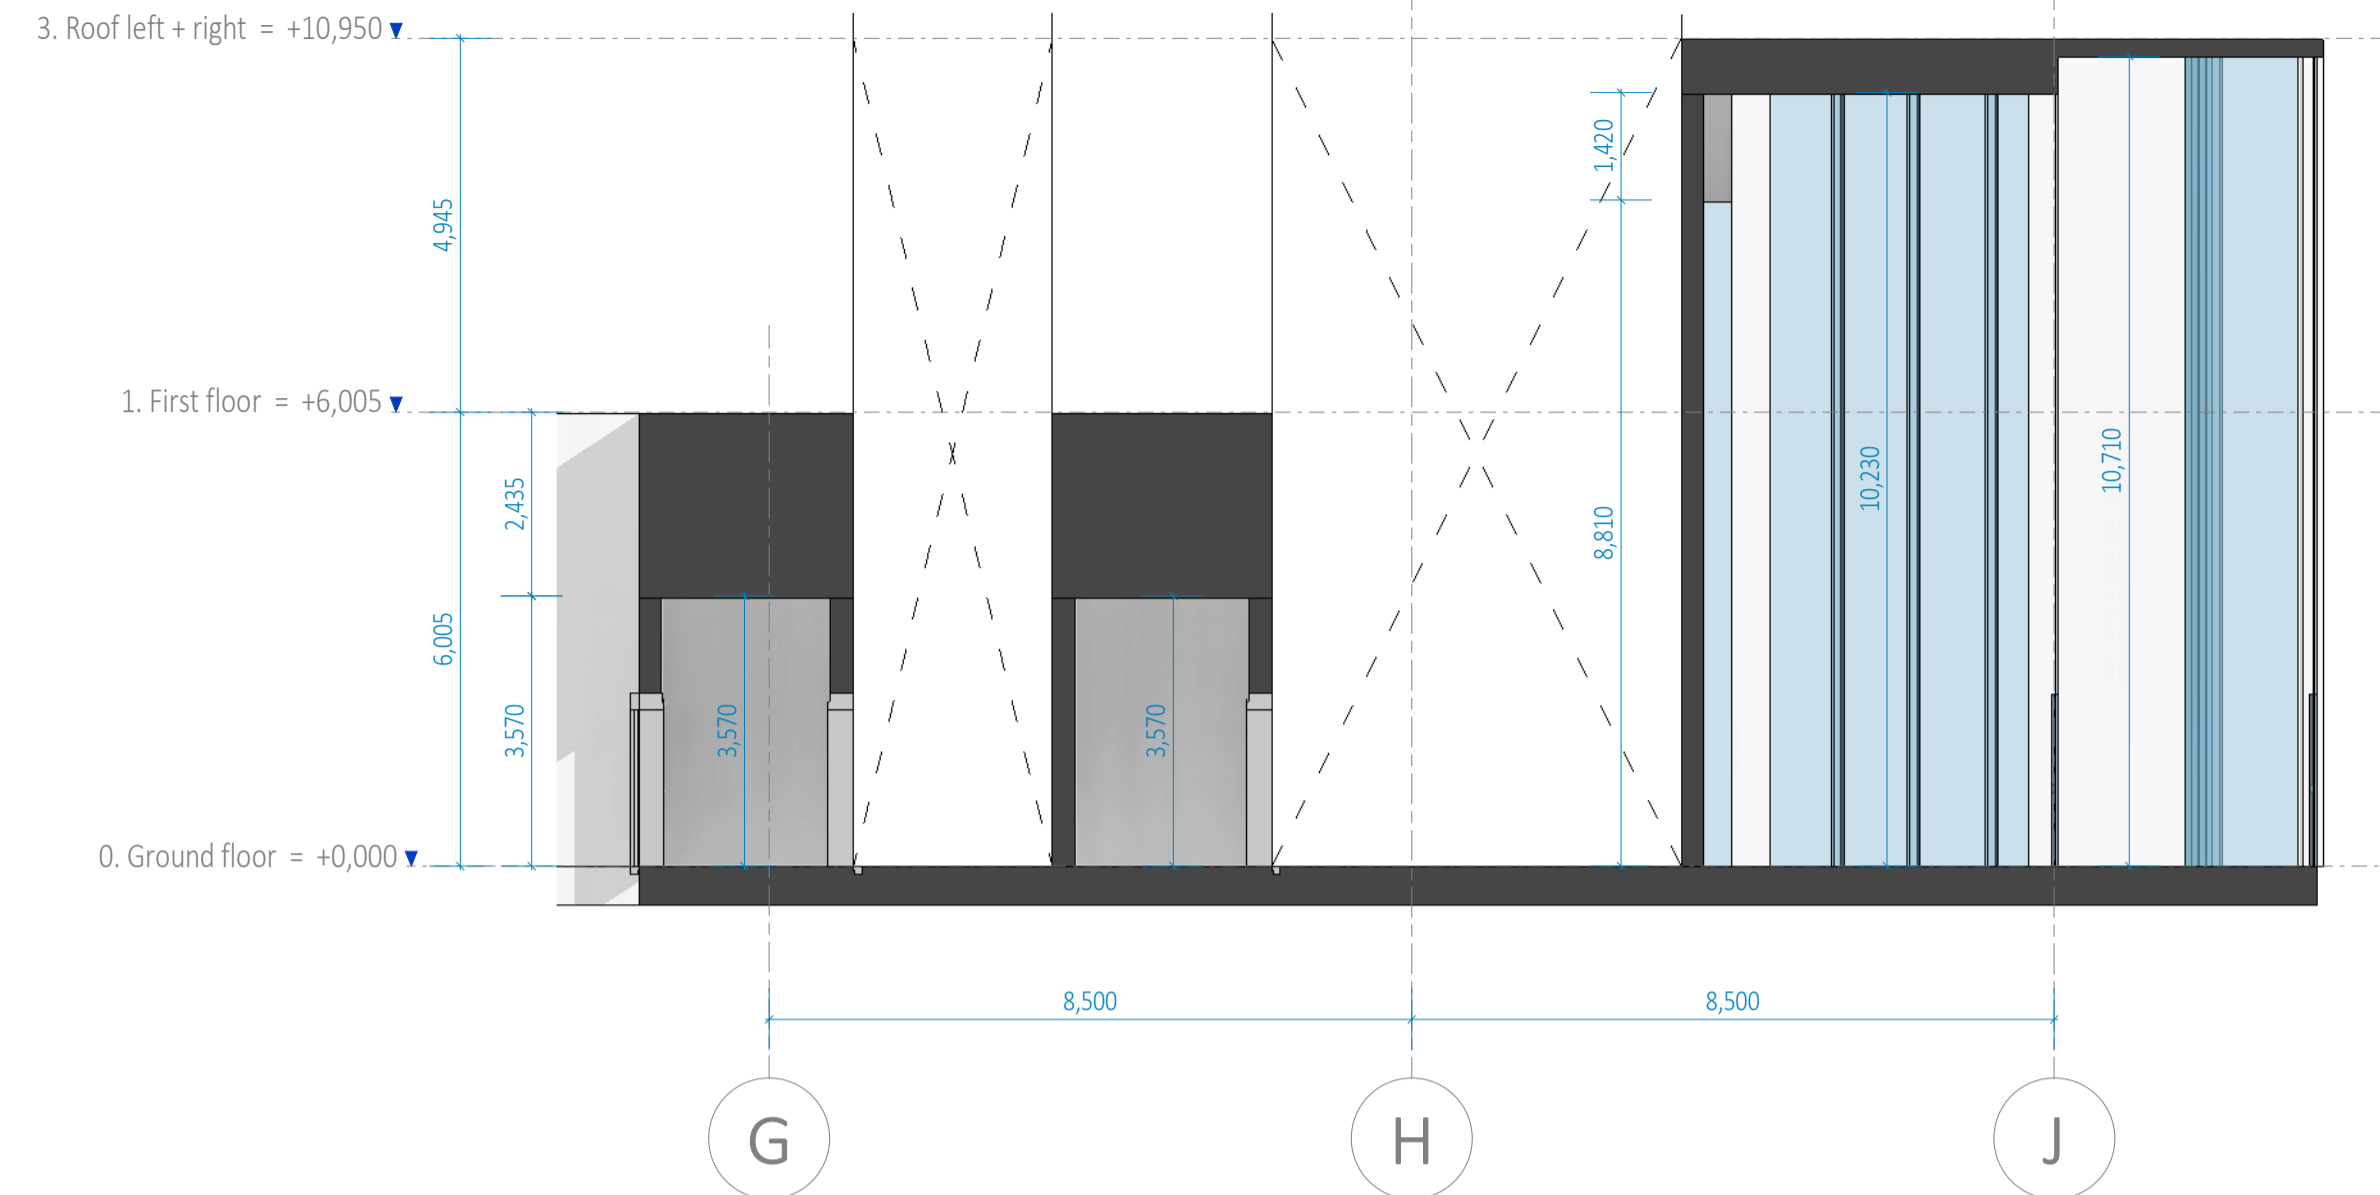


Profile 14
M 1 : 100

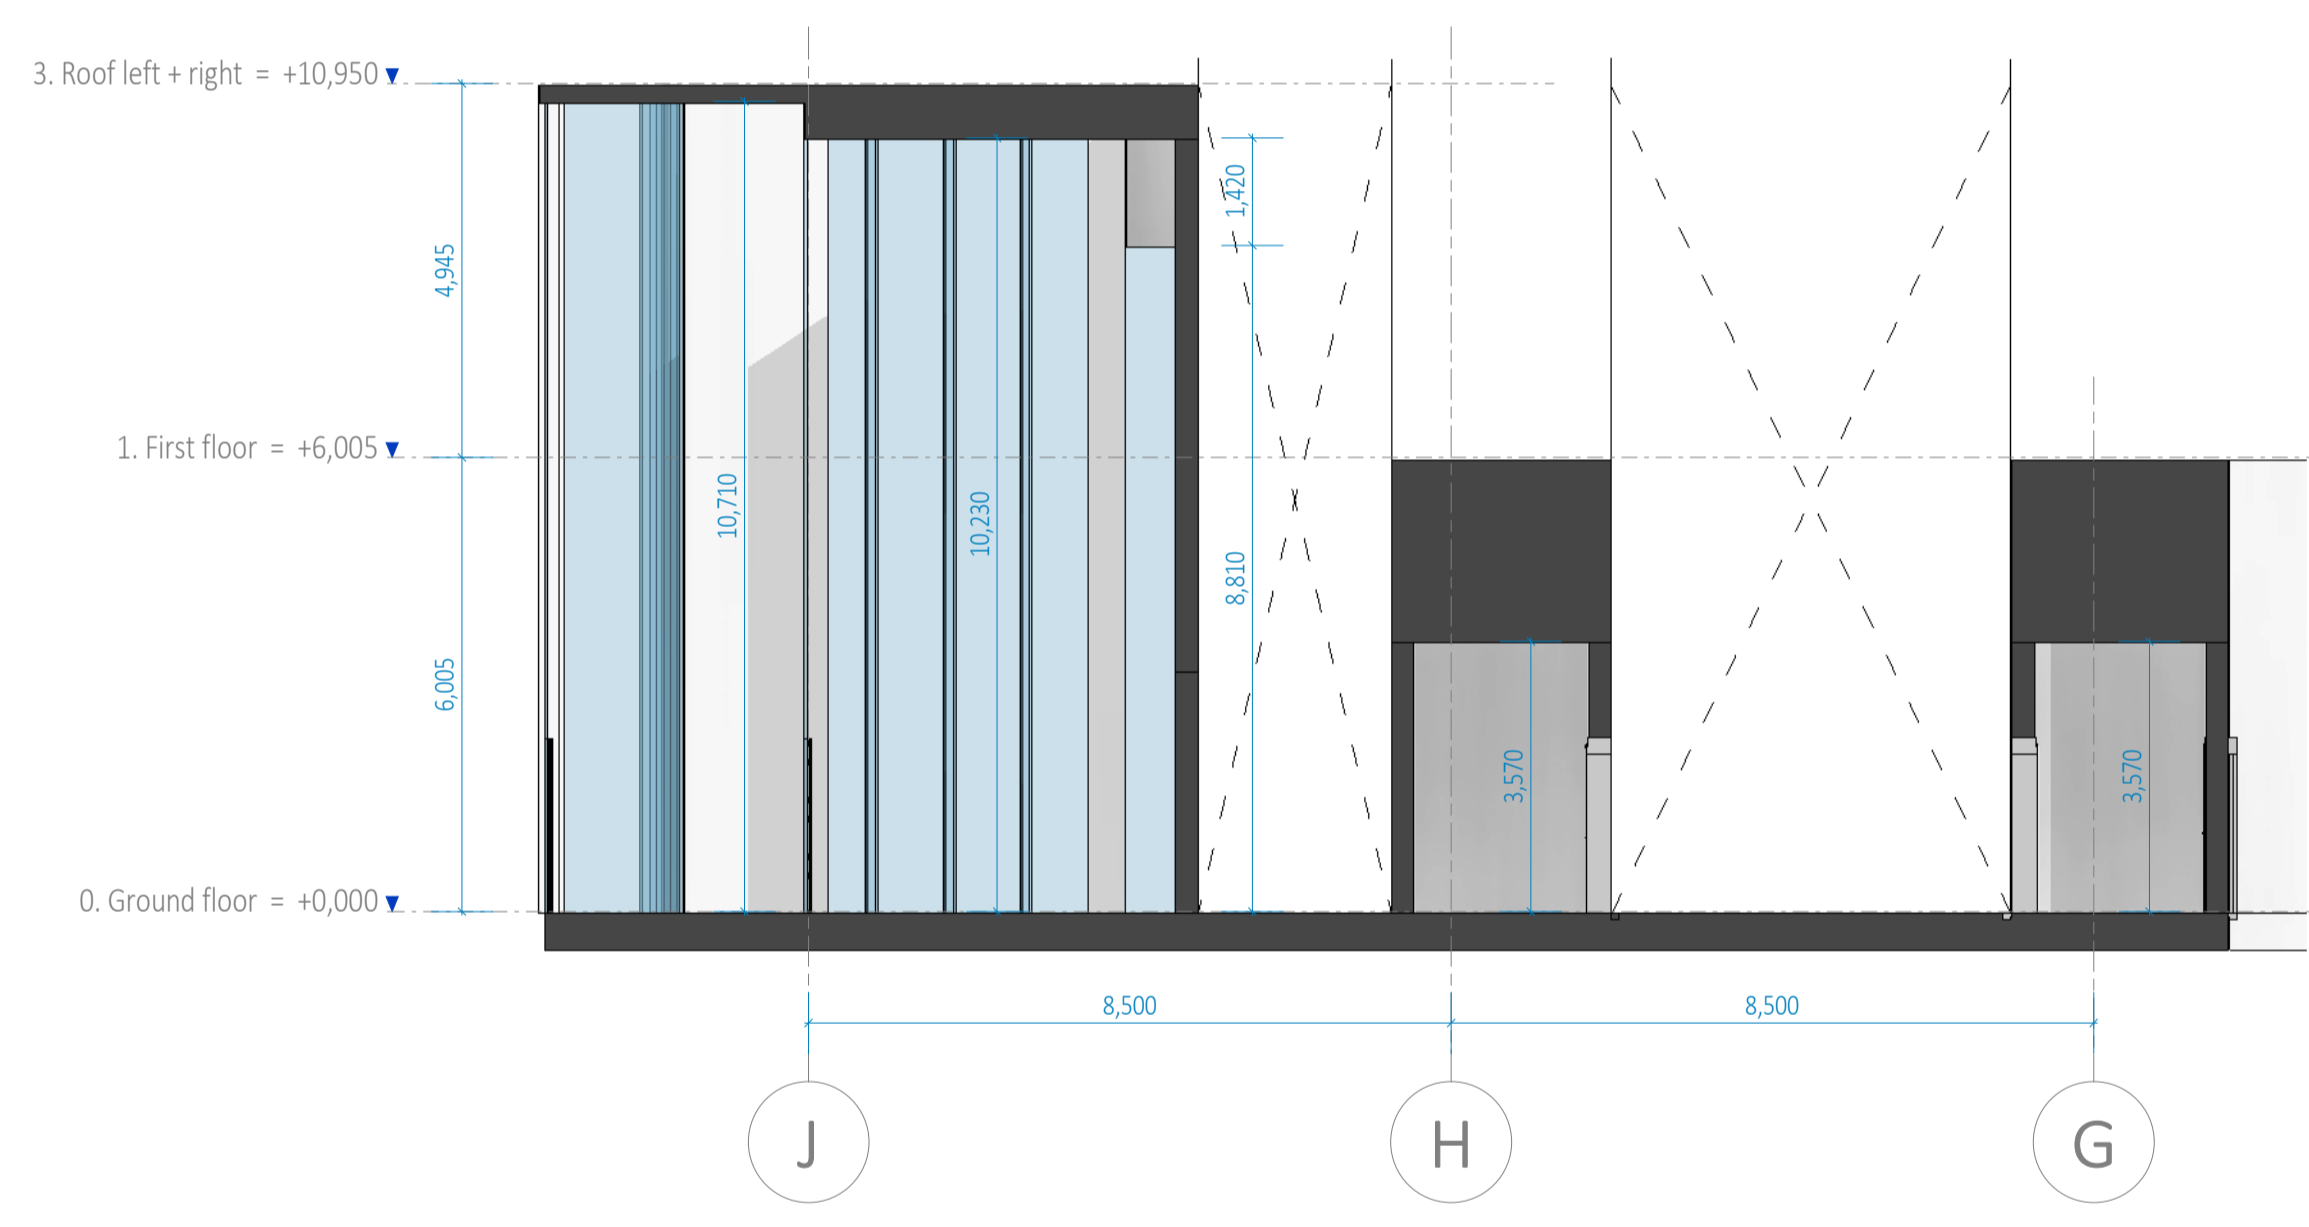


Profile 12
M 1 : 100

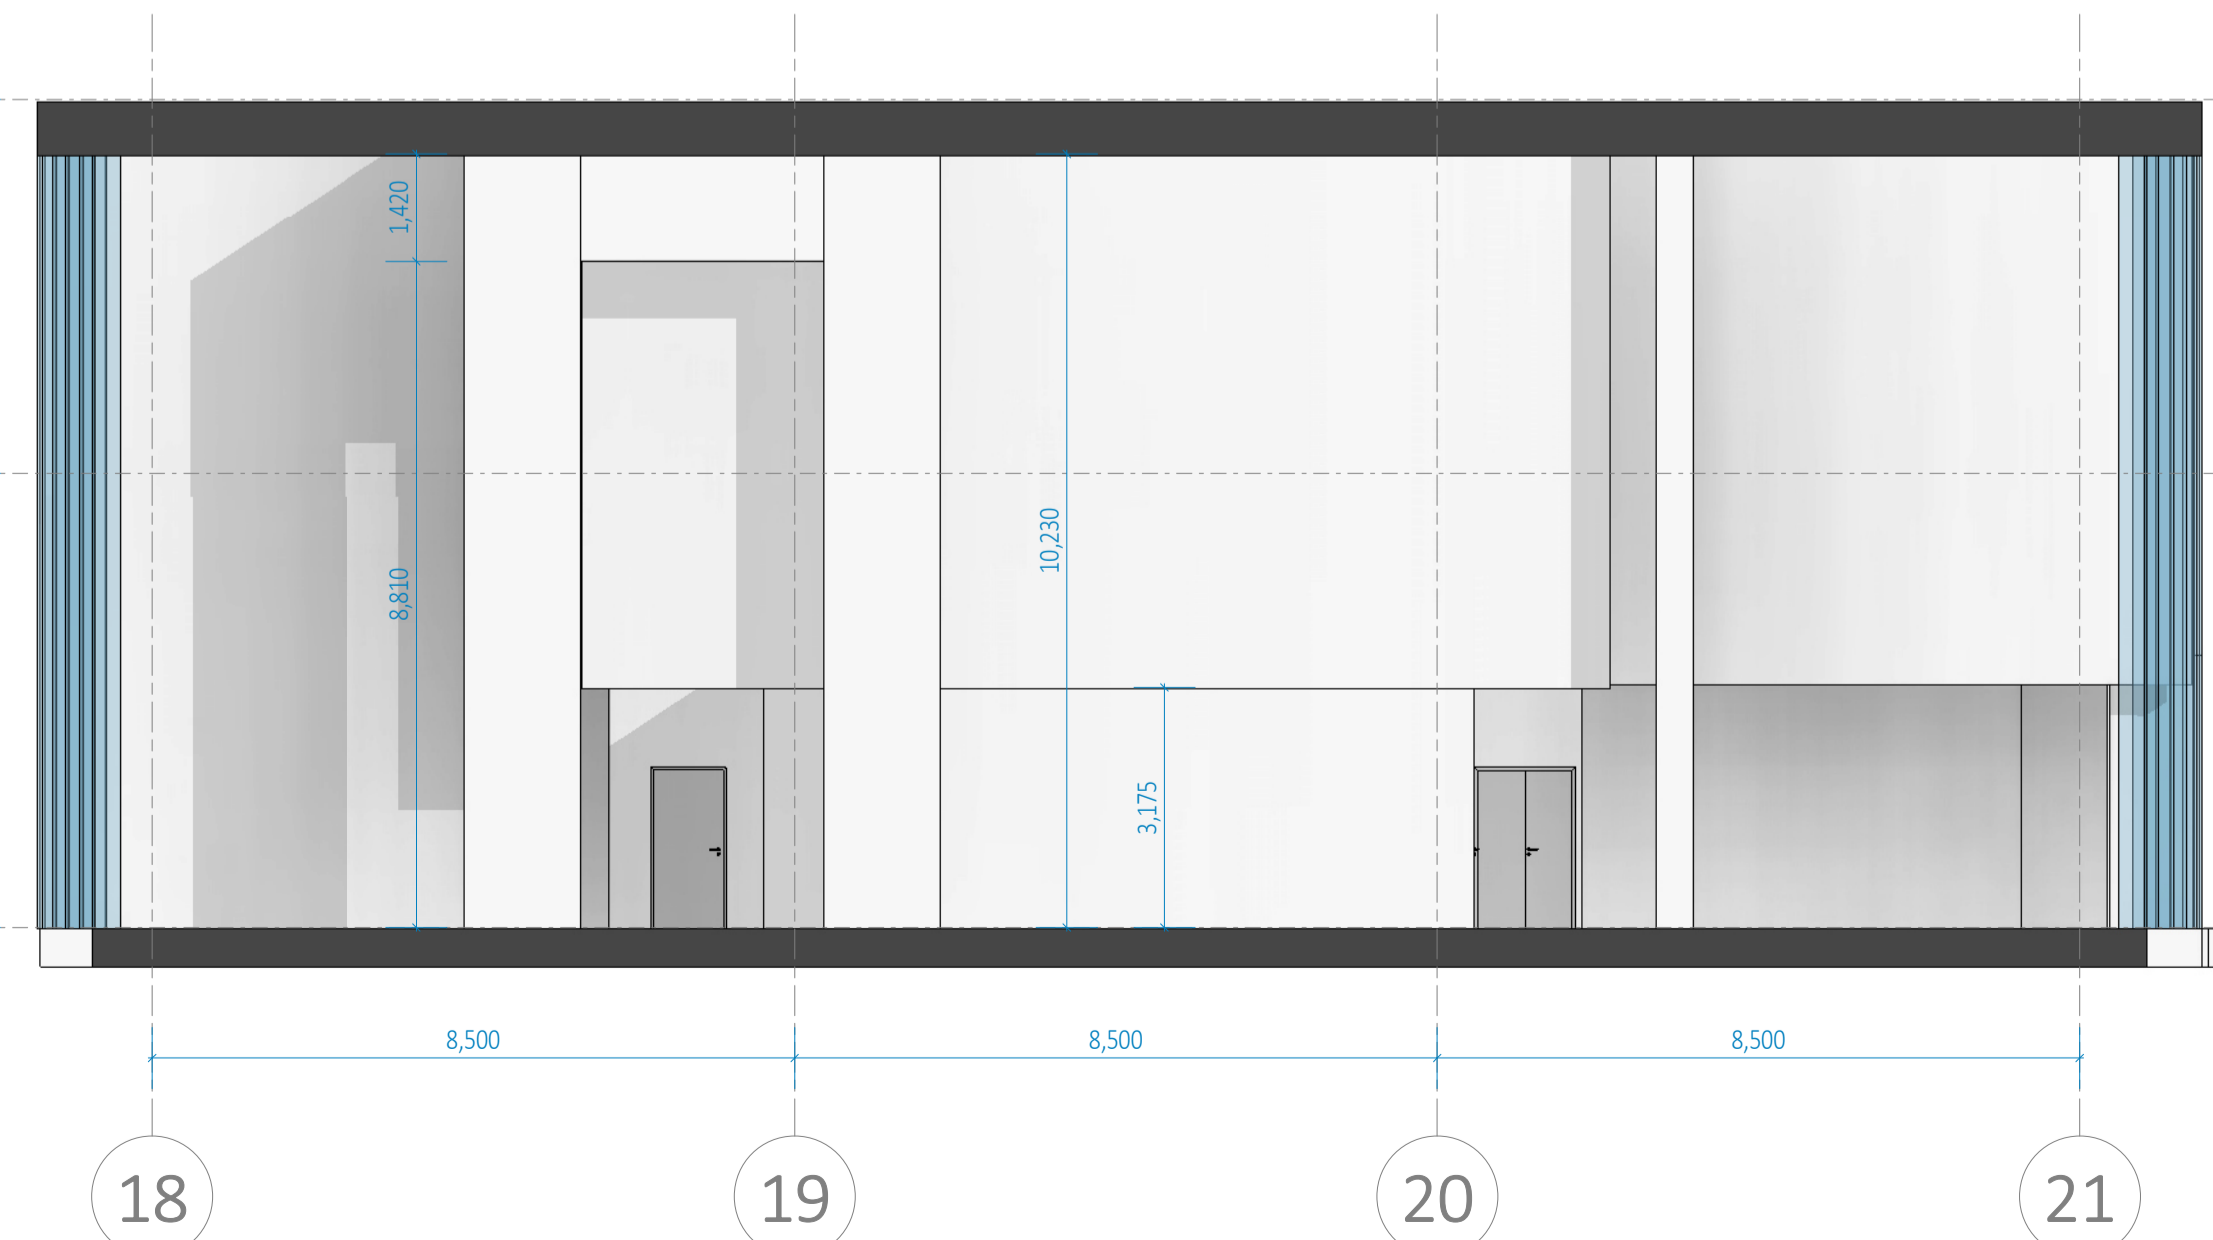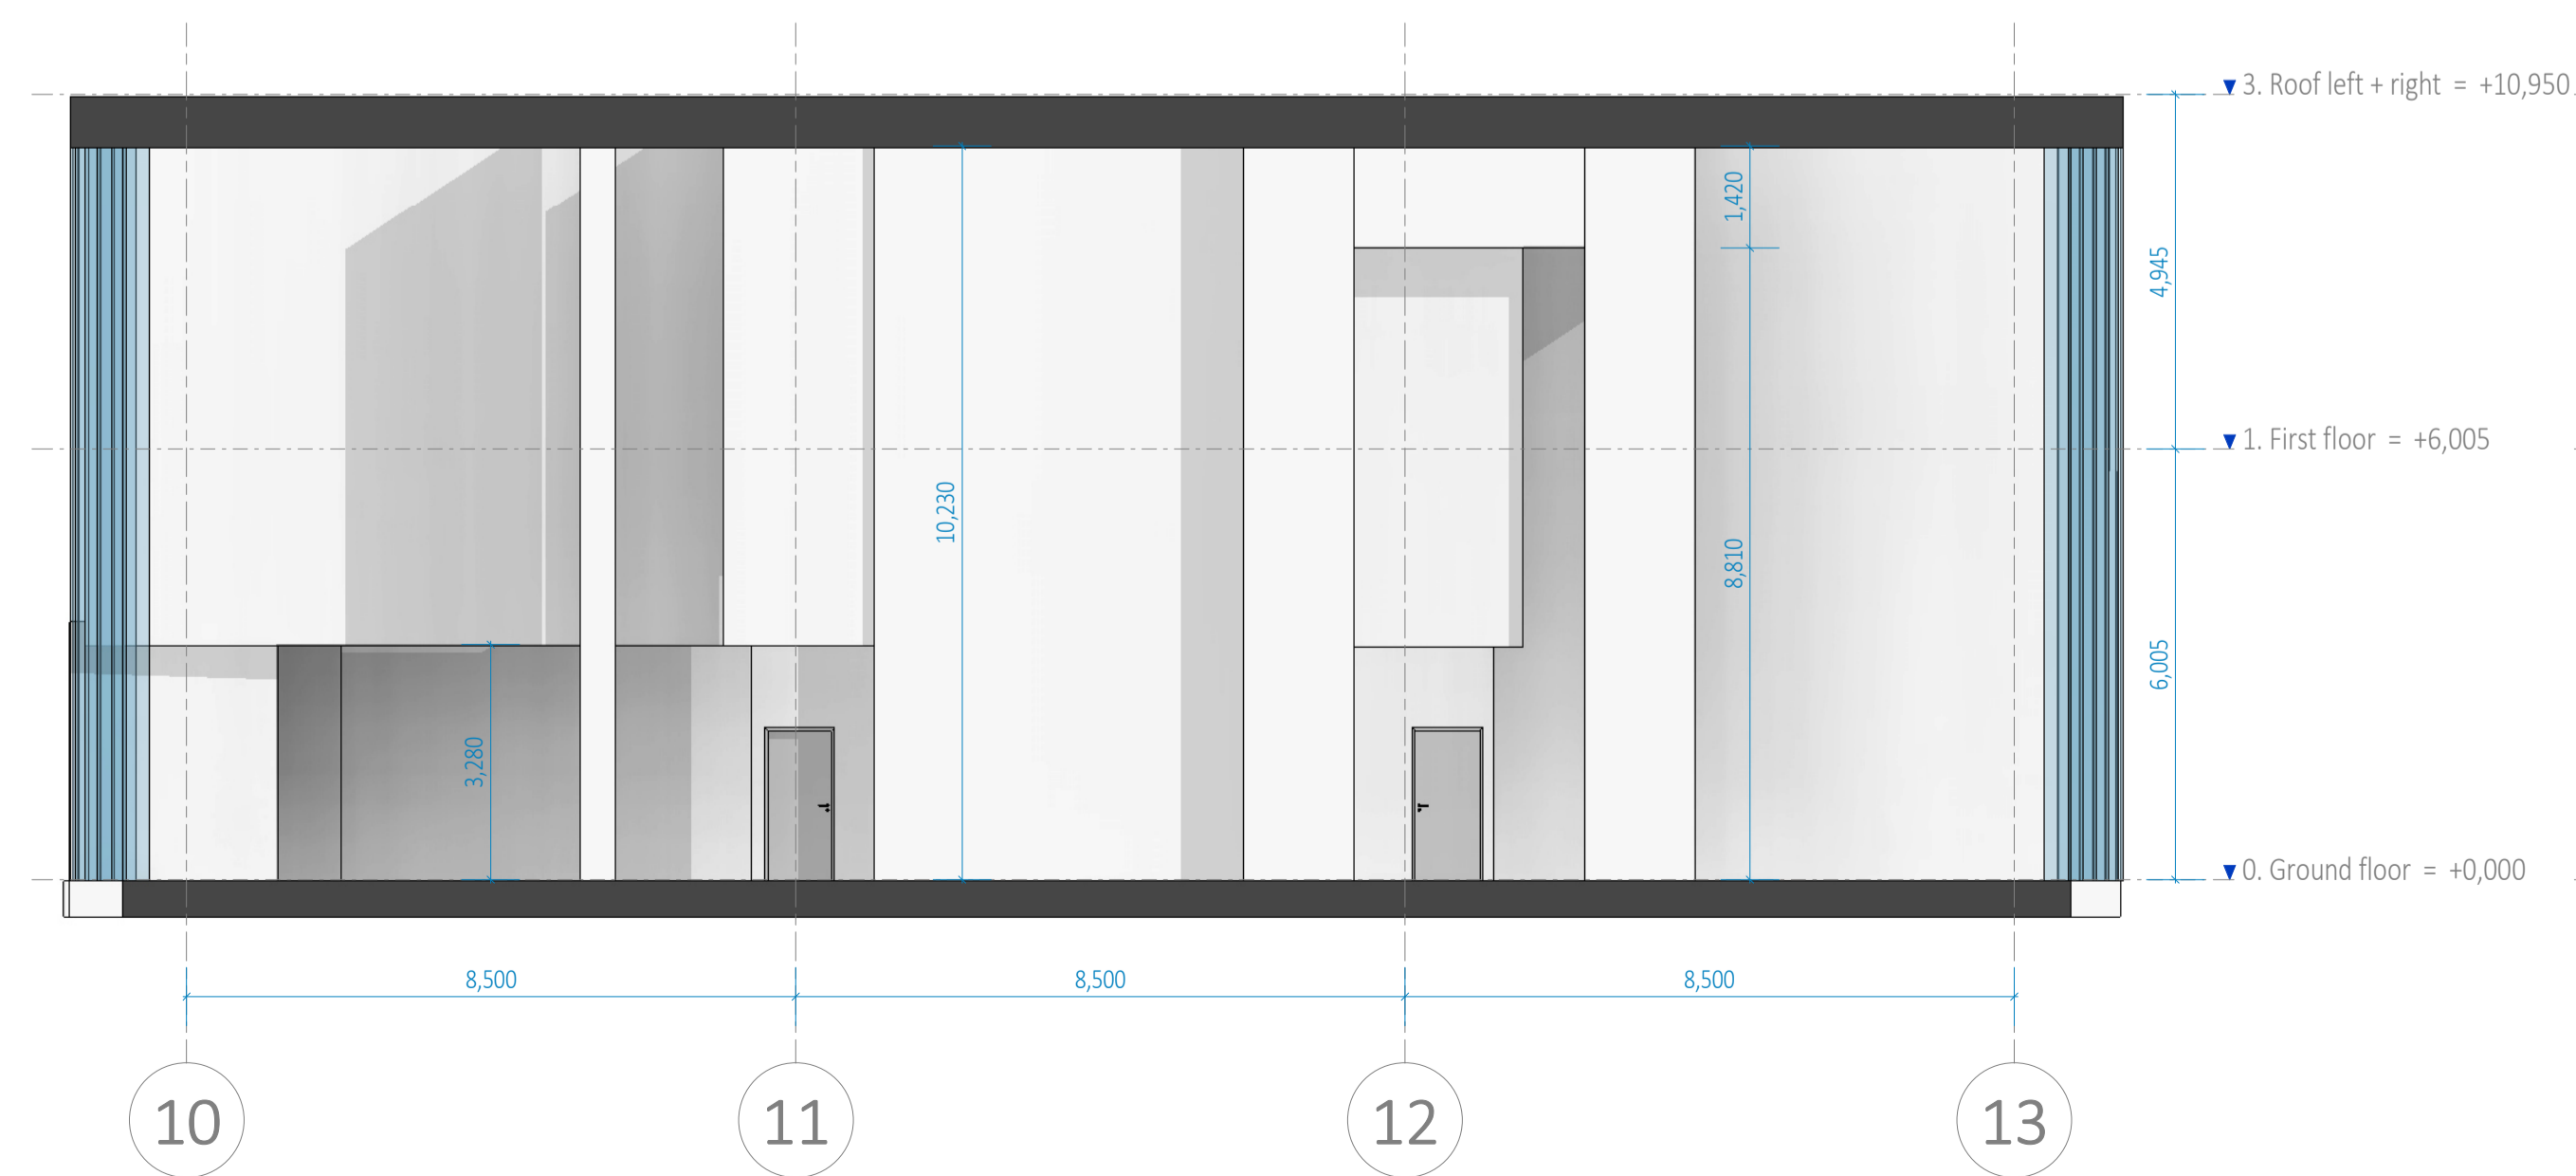

Profile 10
M 1 : 100

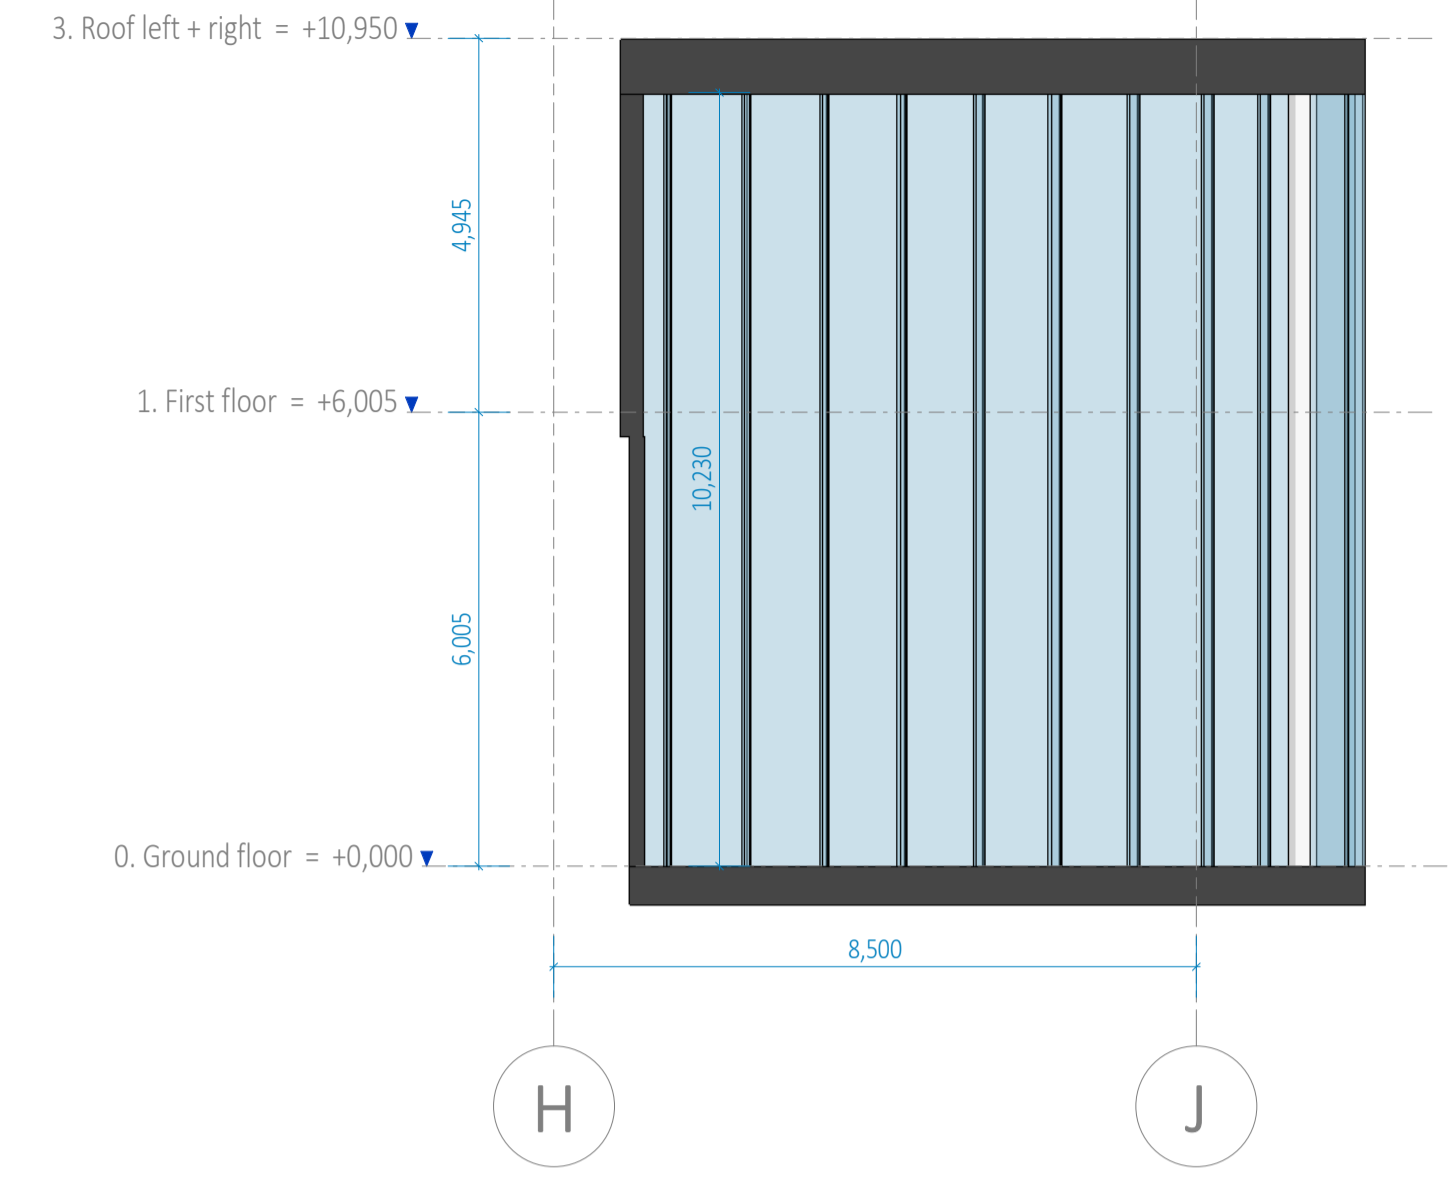

Profile 15
M 1 : 100

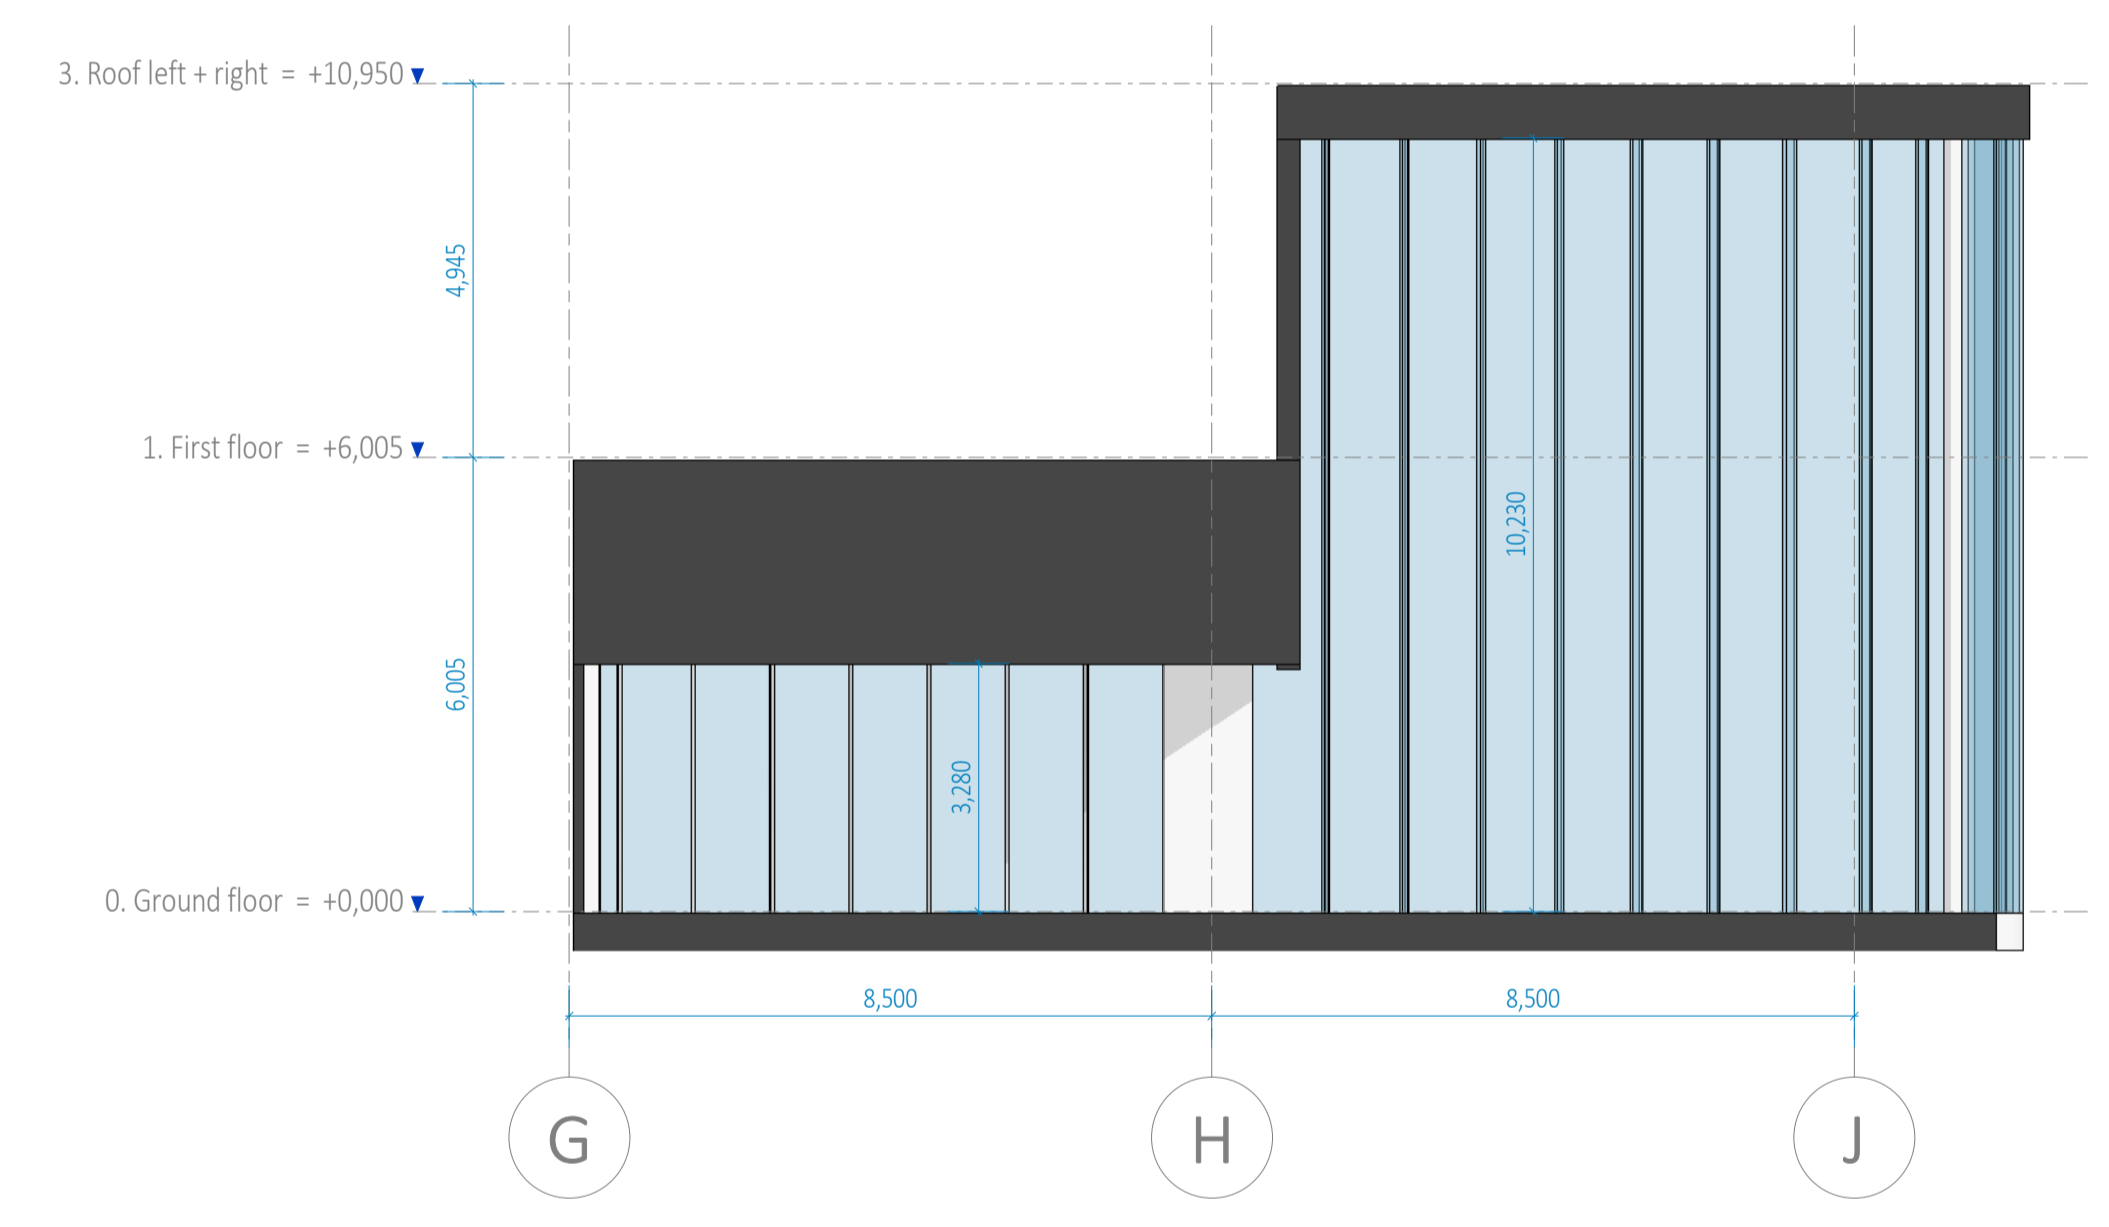

Project: RAK Julphar Avenue & Towers

Profiles 8 - 15

Sheet No. 06
Scale 1 : 100
Date 06.02.2024

00:31:25